


T.15S. R.39E. W.M.

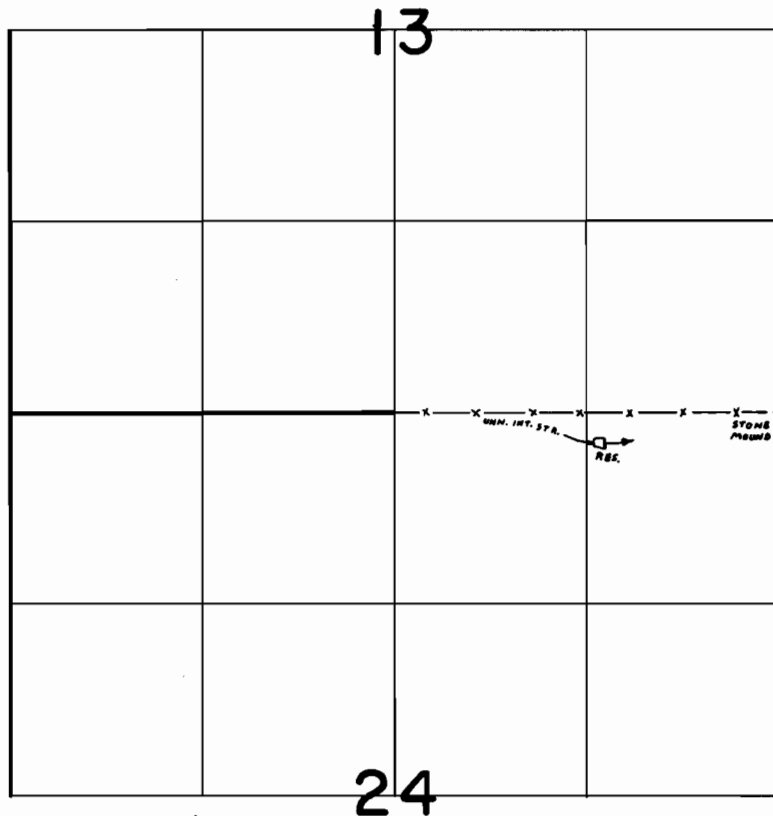

DAM LOC: 210'S. $\frac{1}{2}$ 1190' W. fr. N.E. Cor. SEC. 24.

FINAL PROOF SURVEY
UNDER

Application No. R-44420 Permit No. R-5114
IN NAME OF
DON OAKES

Surveyed Aug. 2 1979, by C. L. HUGHES
Aug. 22, 1985, L. TOLL