


T.21S.,R.46E.,W.M.

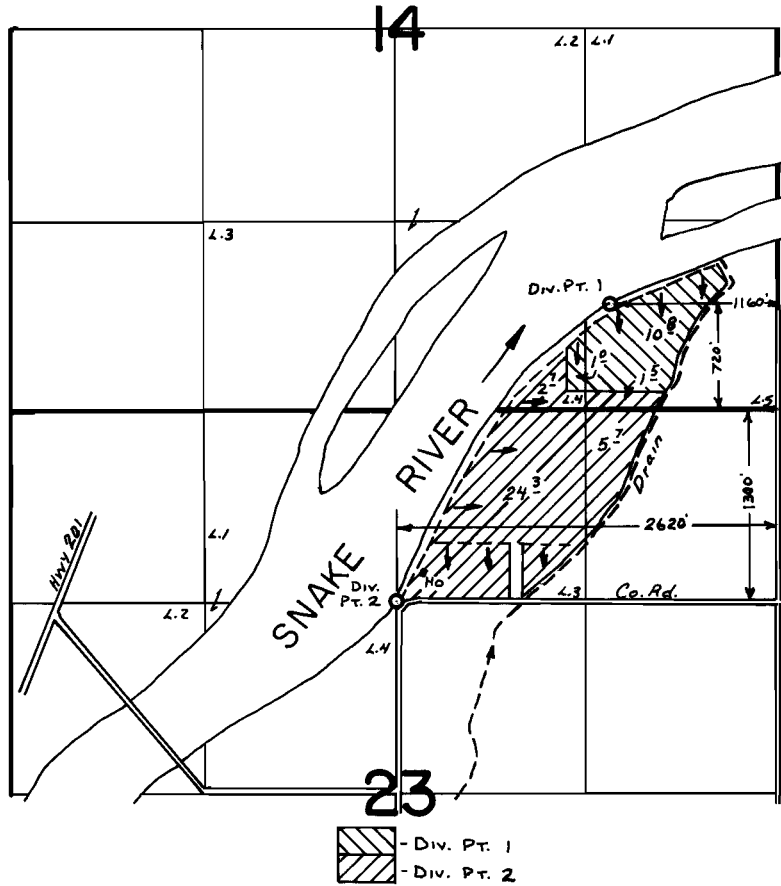

FINAL PROOF SURVEY
UNDER

Application No. .55498.. Permit No. .41837.....
IN NAME OF

.....**JAMES H. MILLER**.....

Surveyed .Aug...20. 1983., by .L..M..TOLL.....