

Form AI-187
March 1961


UNITED STATES
DEPARTMENT OF THE INTERIOR
BUREAU OF LAND MANAGEMENT

SECTION _____

Oregon State Water Filings

TOWNSHIP 13S, RANGE 41E, W. M.

RACEY BROTHERS SPRING ^{North}

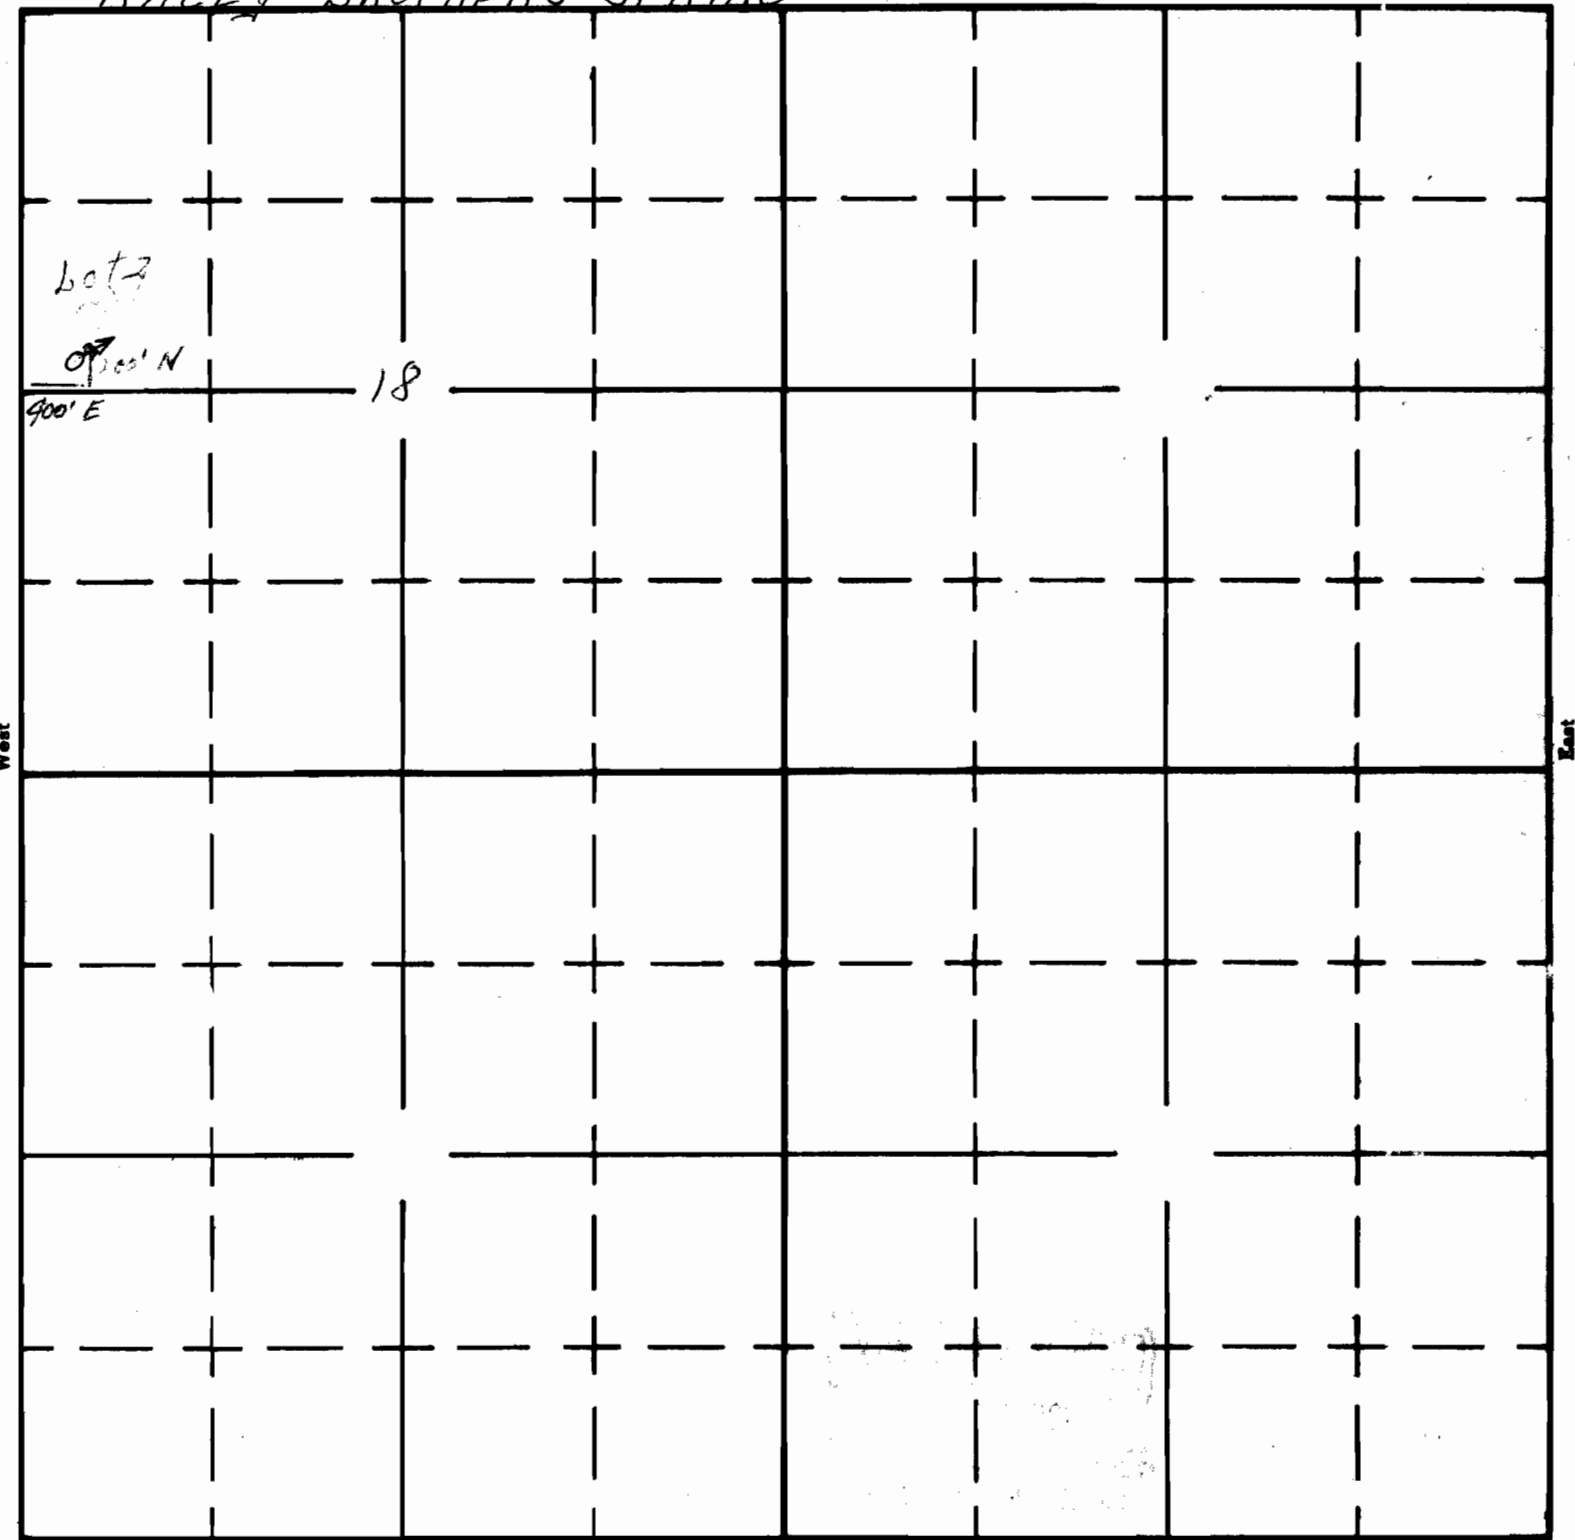

South

APPLICATION No. 36935
PERMIT No. 43069