


T.18S.,R.45E.,W.M.

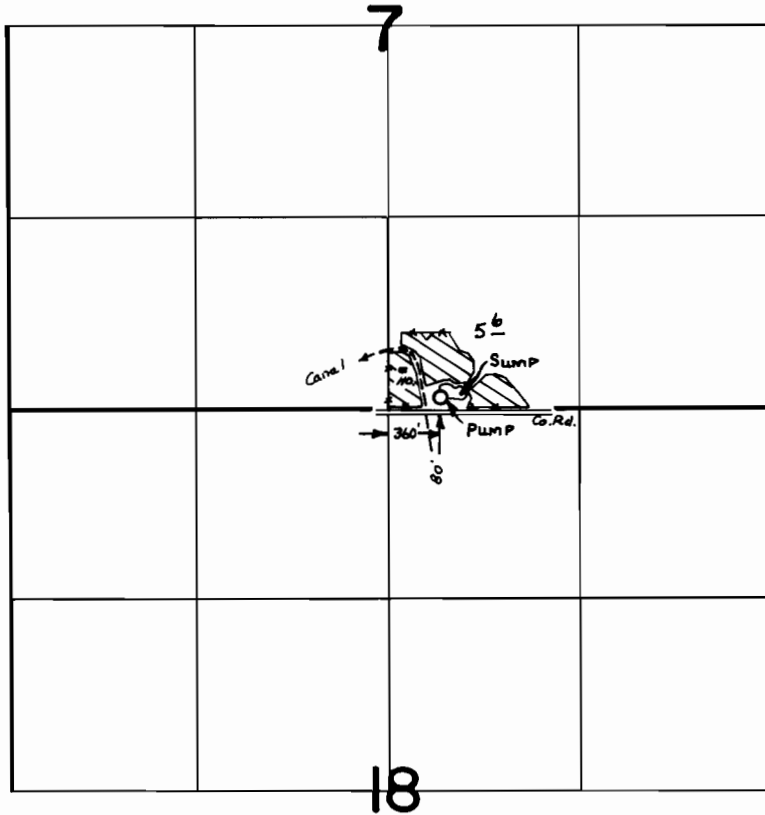

FINAL PROOF SURVEY
UNDER

Application No. ..G:9697. Permit No. ..G:9197.....
IN NAME OF

.....**JAKE W. ELFERING**.....

Surveyed Aug....19... 19.83, by ..L.M.TOLL.....