


T. 4 N. R. 35 E. W. M.

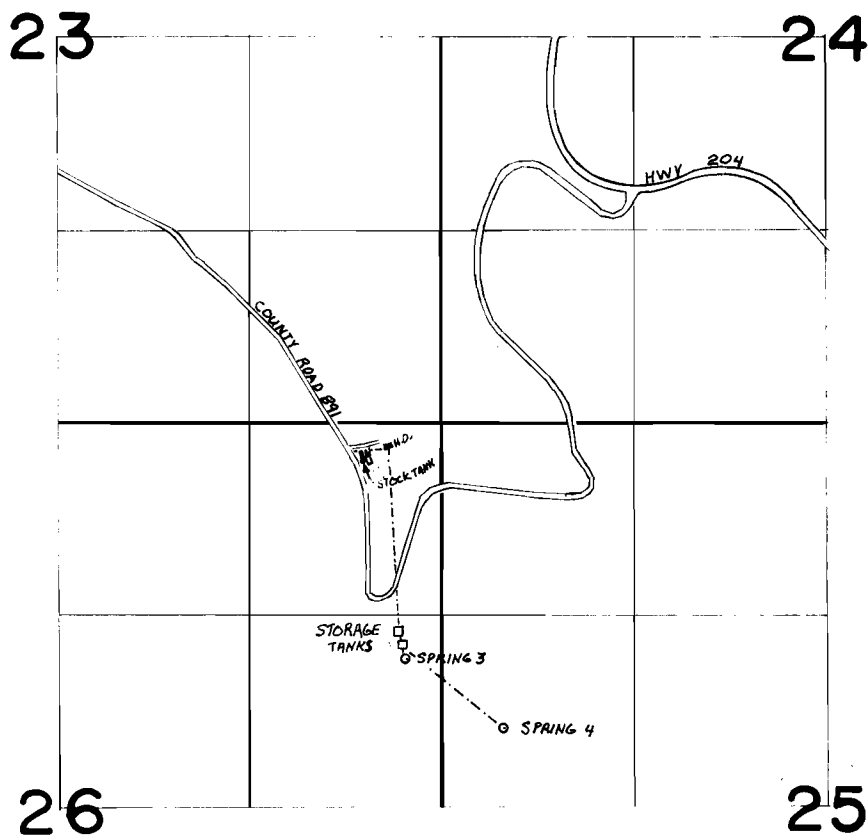

SCALE: 1"=1320'



SPRING 3 LOCATED 1620'S. AND 250 W. FROM NE SEC. COR. SEC. 26

SPRING 4 LOCATED 2080'S. AND 420'E. FROM NW. SEC. COR. SEC. 25

FINAL PROOF SURVEY UNDER

Application No. 57518..... Permit No. 43324.....
IN NAME OF

.....RUTH A. SAMPSON.....

Surveyed APRIL 30, 1985., by V.L. CHURCH.....