

G-9322

55329


JAN 8 1987

# T. 4 N. R. 29 E. W. M.

BY



SCALE: 1"=1320'

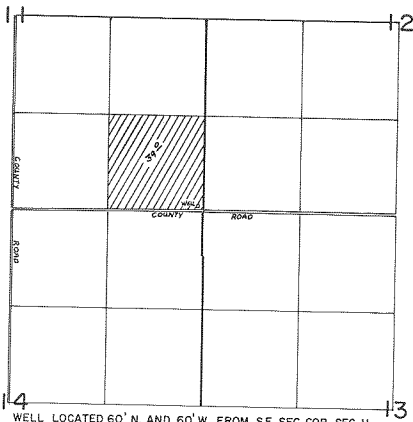

## FINAL PROOF SURVEY UNDER

Application No. G-10236 Permit No. G-9322.....  
IN NAME OF

.....MILLS MINT FARM INC.....

Surveyed JAN 28.... 1985., by V.L. CHURCH.....