


T. 1N., R. 42 & 43E., W.M.

SCALE: 1"=1320'

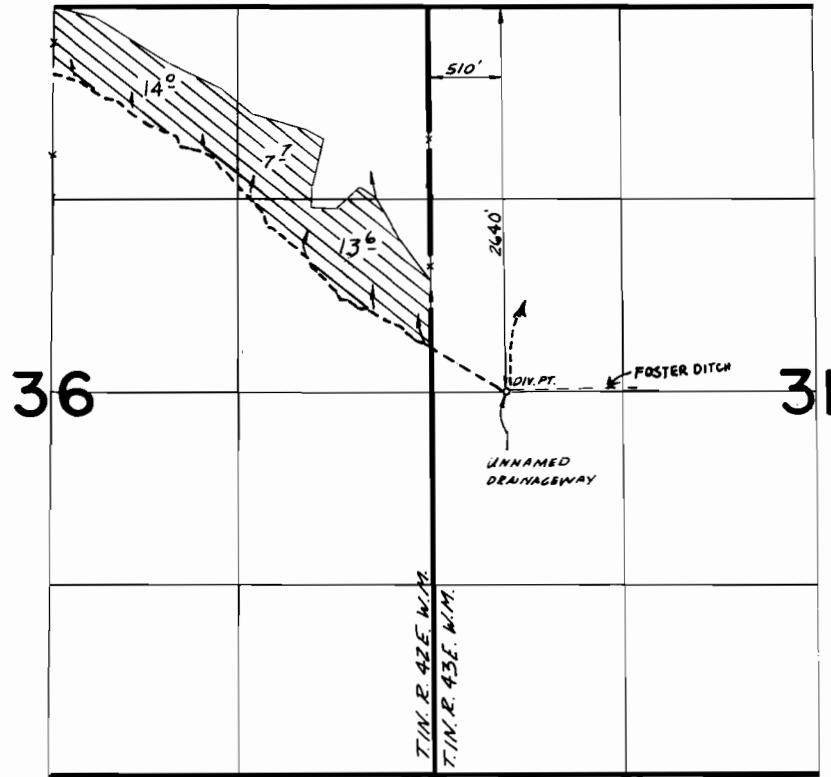

FINAL PROOF SURVEY
UNDER

Application No. 43240 Permit No. 32326
IN NAME OF

C. ELLENA WYCKOFF

Surveyed 8-29 1978, by R. E. BARWILL