
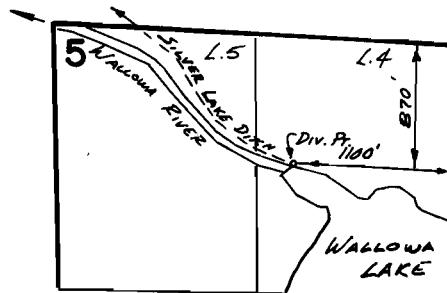


T. 3S., R. 45E., W. M.

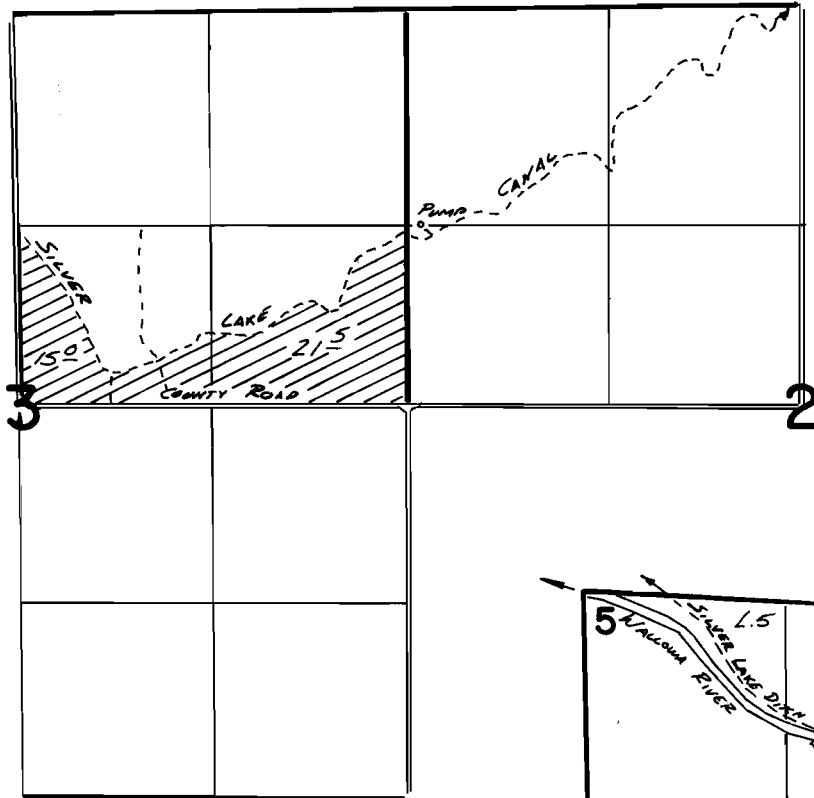

FINAL PROOF SURVEY
UNDER

Application No. **54202** Permit No. **40567**
IN NAME OF

LUTHER E. THORNBURGH

Surveyed *Aug. 11* 1932, by *V. L. Church*