


T. 3S., R. 46E., W. M.

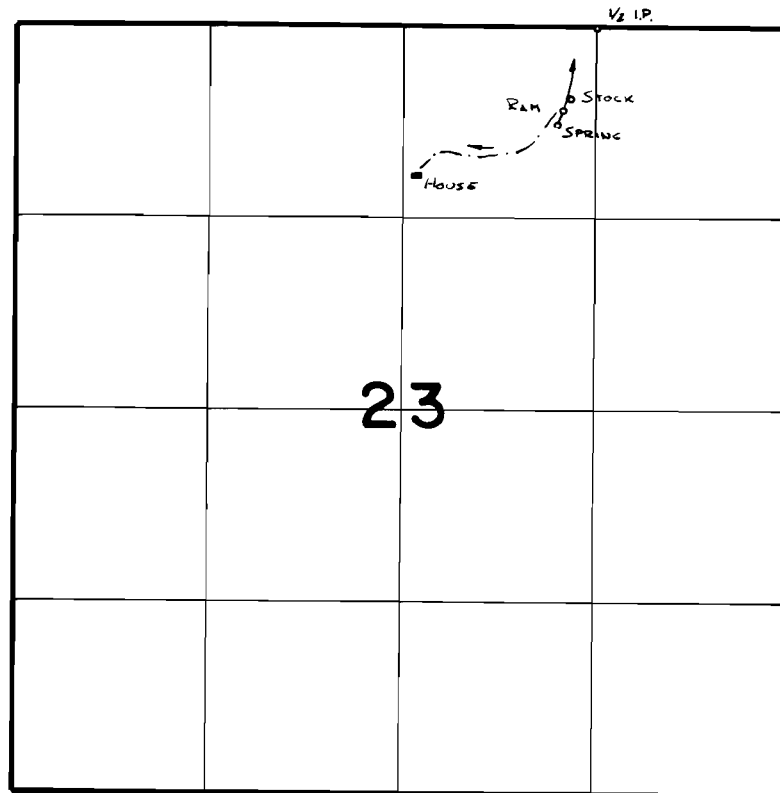

SPRING LOC: 680' S. & 1570' W. FROM NE COR SEC 23

FINAL PROOF SURVEY
UNDER

Application No. **52101**... Permit No. **42469**...
IN NAME OF

.....**JAMES H. FOSSEN**.....

Surveyed *8-18*..... 19*81*., by *V.L. Church*.....