


T.2S., R.44E., W.M.

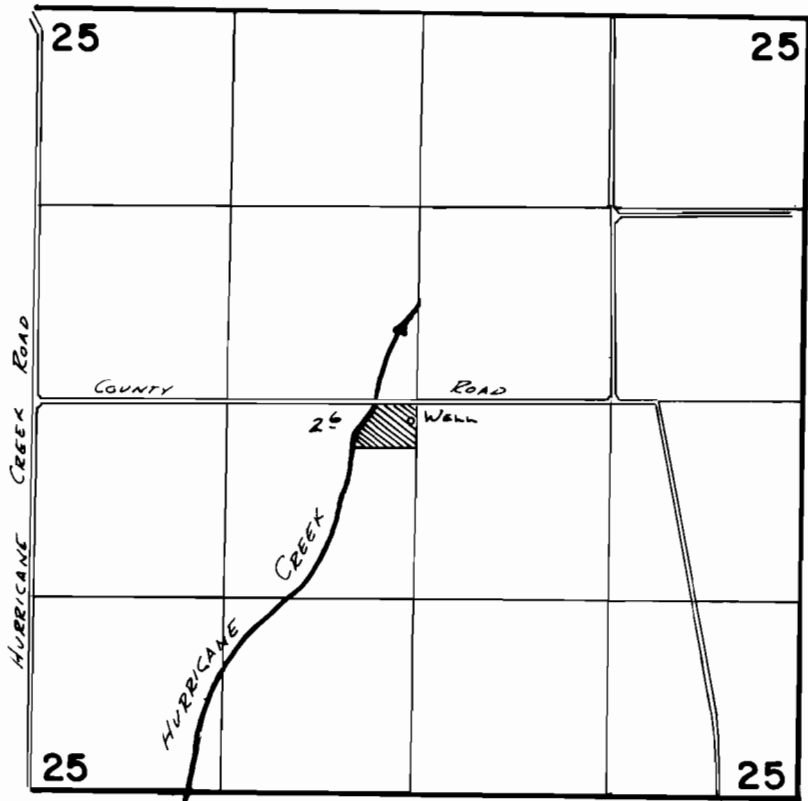

WELL LOC: 130'S. & 50'W. FROM CENTER COR. SEC 25

FINAL PROOF SURVEY
UNDER

Application No. G: ~~9443~~ Permit No. G: 8868...
IN NAME OF

.....**CHARLES R. DALY**.....

Surveyed 8-10..... 1982, by V.L. Church.....