


T.2N. R.11E. W.M.

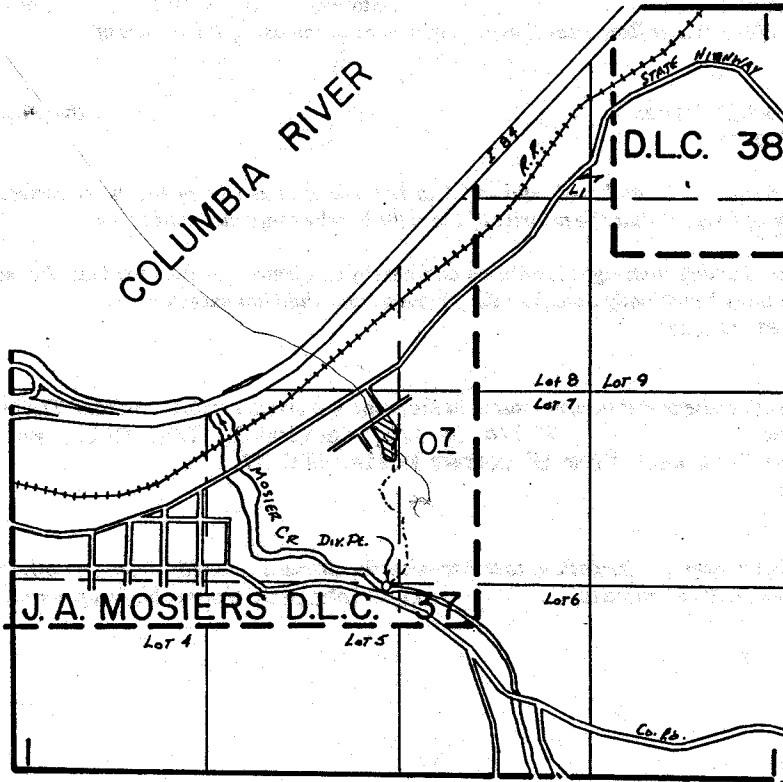

**FINAL PROOF SURVEY**  
UNDER

Transfer No. 3916  
Application No. .... Permit No. ....  
IN NAME OF

..... EDWARD B. DIXSON .....

Surveyed March 10, 1982, by T. PAUL .....