


P# 3182

T.2N.,R.12E.,W.M.

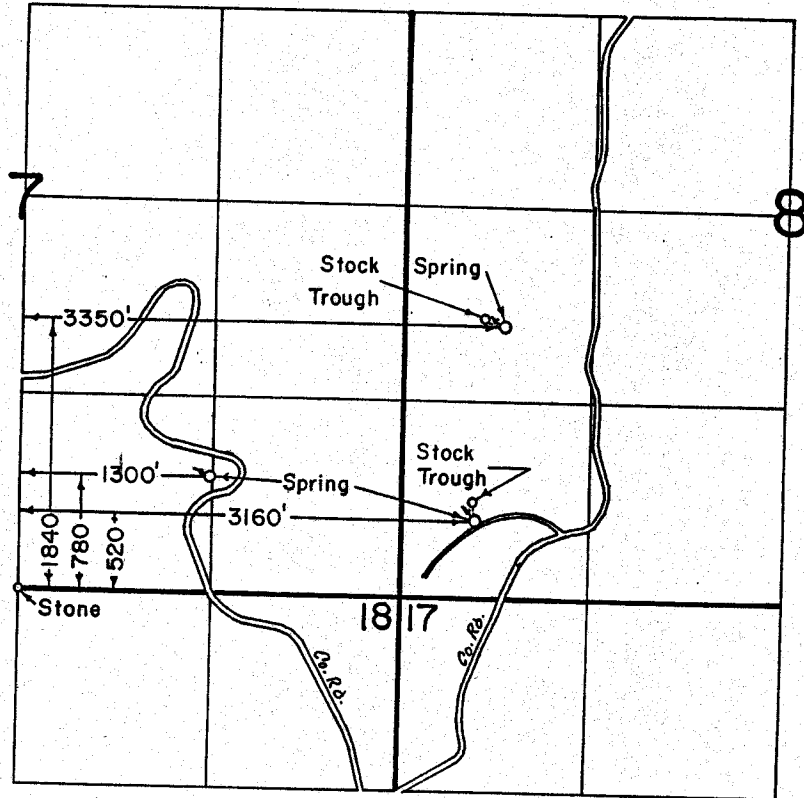

FINAL PROOF SURVEY
UNDER

Application No. 52576... Permit No. 39815.....
IN NAME OF

WILLIAM L. & G. LOUISE LEININGER.

Surveyed Sep. 30, 1982, by T. J. Paul.....