T. 4S. R. 13 & 14E. W.M.

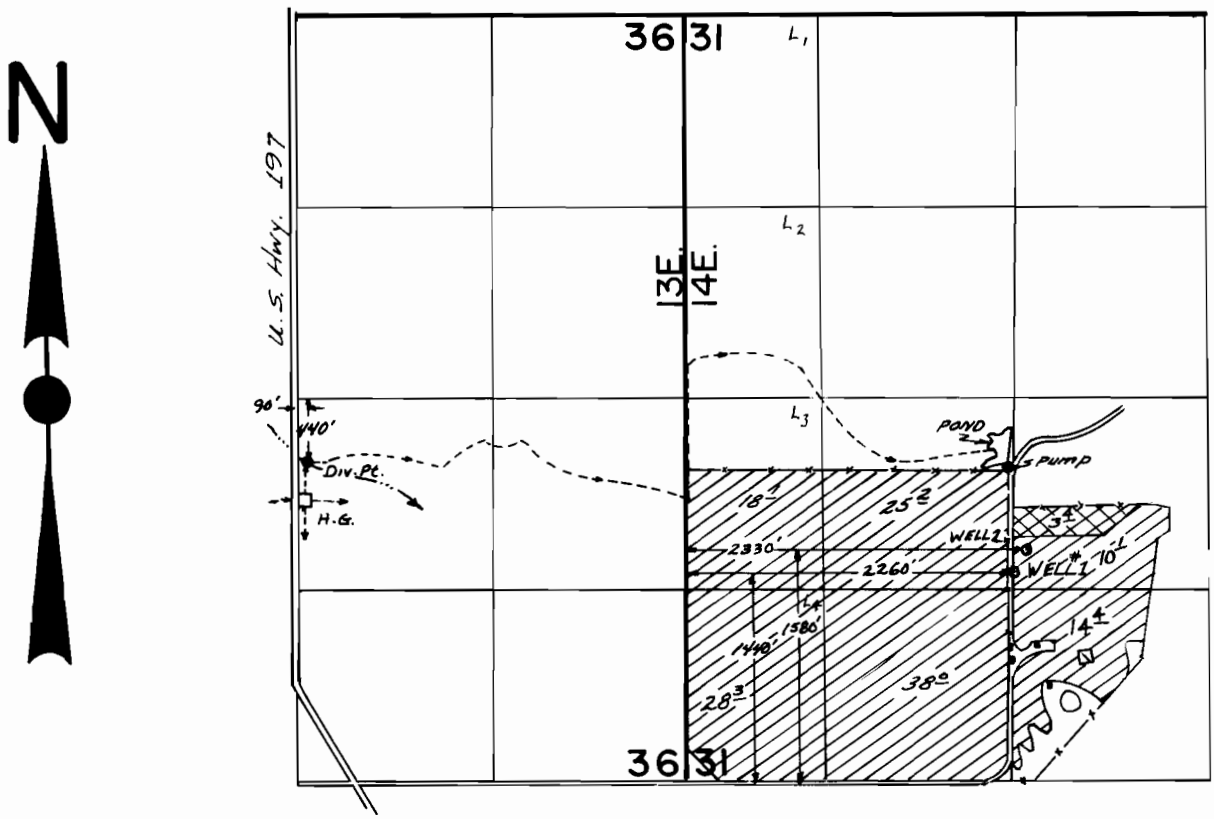

- Primary; PERMIT G-7403, SUPPLEMENTAL; PERMIT 41039
- SUPP'L.; PERMITS G-7403 + 41039

Scale: 1" = 1320'

FINAL PROOF SURVEY

UNDER

Application No. G-7973 (54700) Permit No. G-7403 (41039)

IN NAME OF

VERL E. FLEISCHMAN

Surveyed Sept. 10, 1979, by C.R. RODRIGUEZ.

41065-472-35