


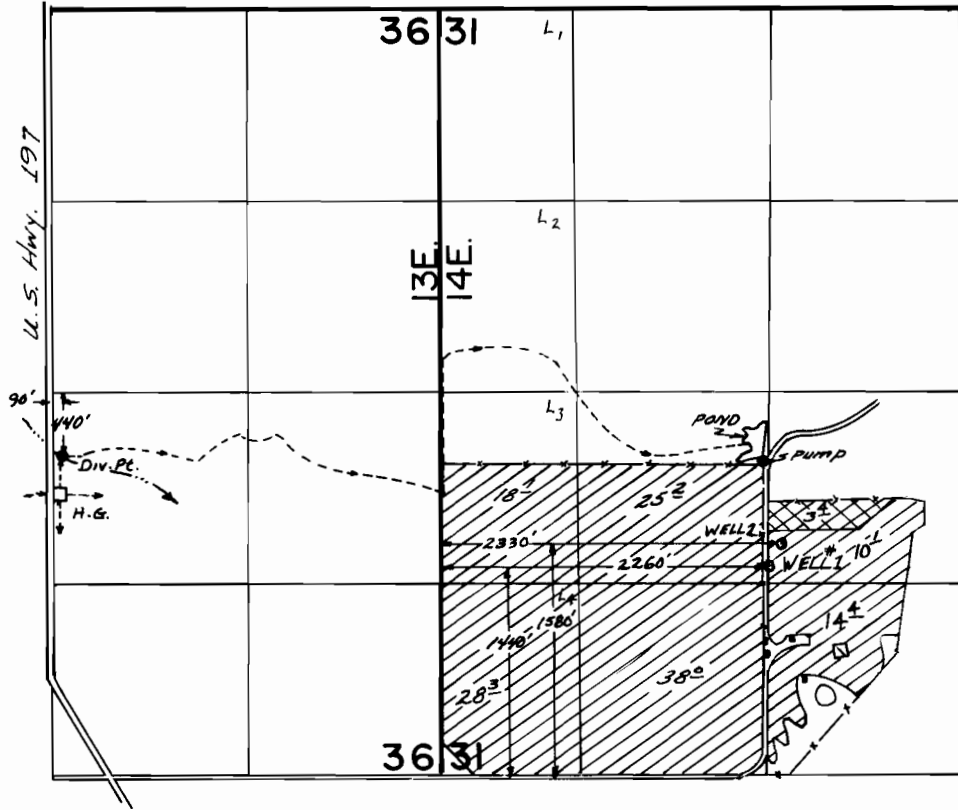

T. 4S. R. 13&14E. W.M.



-  - Primary; PERMIT G-7403, SUPPLEMENTAL; PERMIT 41039
-  - SUPPL.; PERMITS G-7403 + 41039

Scale: 1" = 1320'

FINAL PROOF SURVEY

UNDER

54700 41039
 Application No. G-7973 Permit No. G-7403...
 IN NAME OF

.....VERL E. FLEISCHMAN.....

Surveyed Sept. 10.. 1979., by C.R. RODRIGUEZ.