


P # 44417

T.4S., R.13E., W.M.

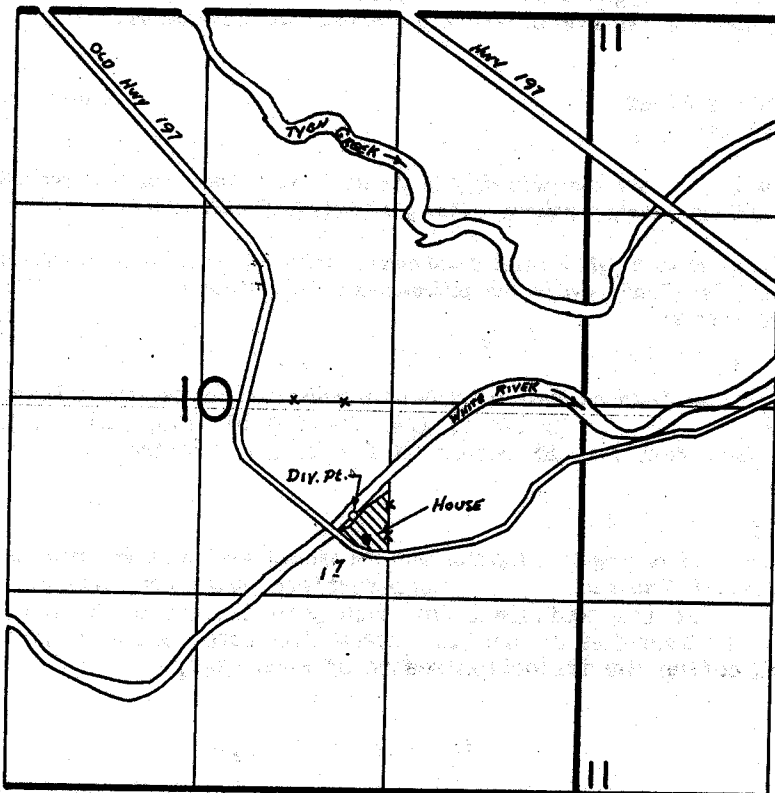

Div. Pt. Loc. 780' S. & 250' W. From The NE Cor. NW1/4 SE1/4 Sec. 10

FINAL PROOF SURVEY
UNDER

Application No. 58961... Permit No. 44417...
IN NAME OF

..... DONALD G. IVERSON

Surveyed Oct. 19 1982, by T. J. Paul.....