


P# G-6536

T. 1 S. R. 14 E. W.M.

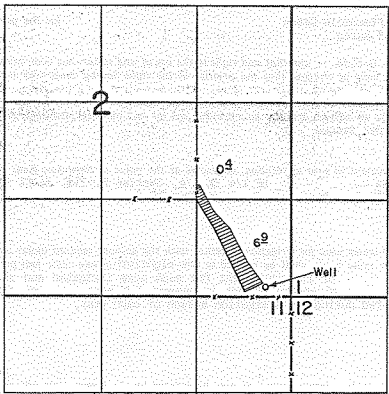

Well Loc. 120' N & 360' W From SE Cor Sec. 2

FINAL PROOF SURVEY UNDER

Application No. G-7049. Permit No. G-6536.
IN NAME OF

GERALD E. KAUFMAN

Surveyed Sept. 20, 1982, by J. Paul