


P# G-6541

T.2N.,R.12E.,W.M.

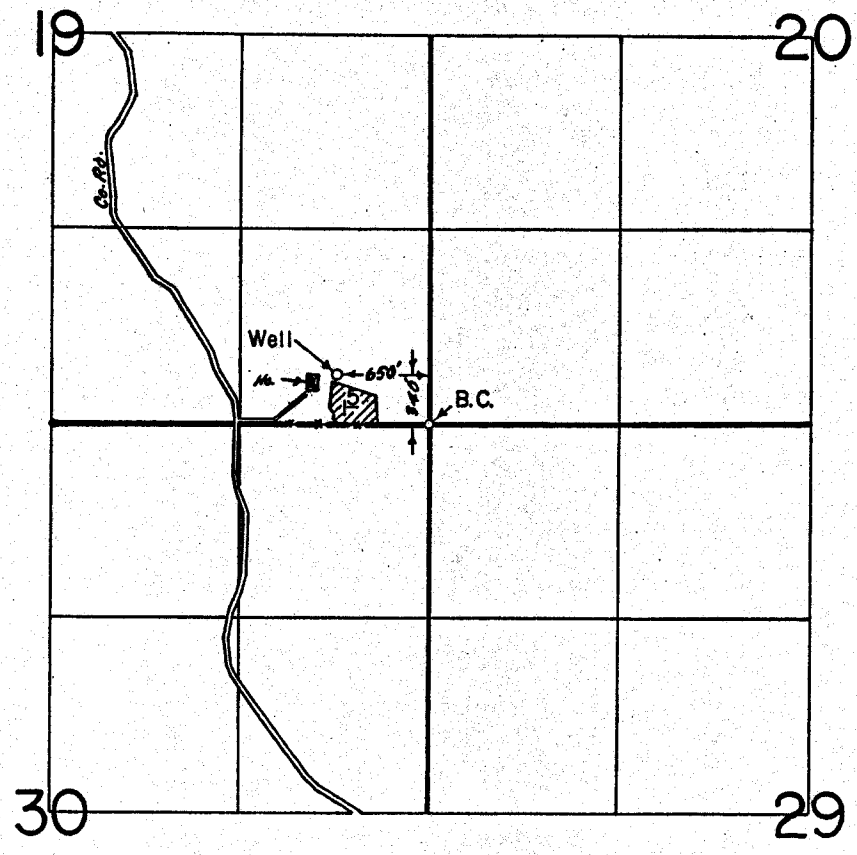

FINAL PROOF SURVEY UNDER

Application No. G-7058 Permit No. G-6541
IN NAME OF

.....JOHN REZNOR WARD.....

Surveyed Sep. 3, 1982, by T. J. Paul.....