


# T.1N.,R.14E.,W.M.

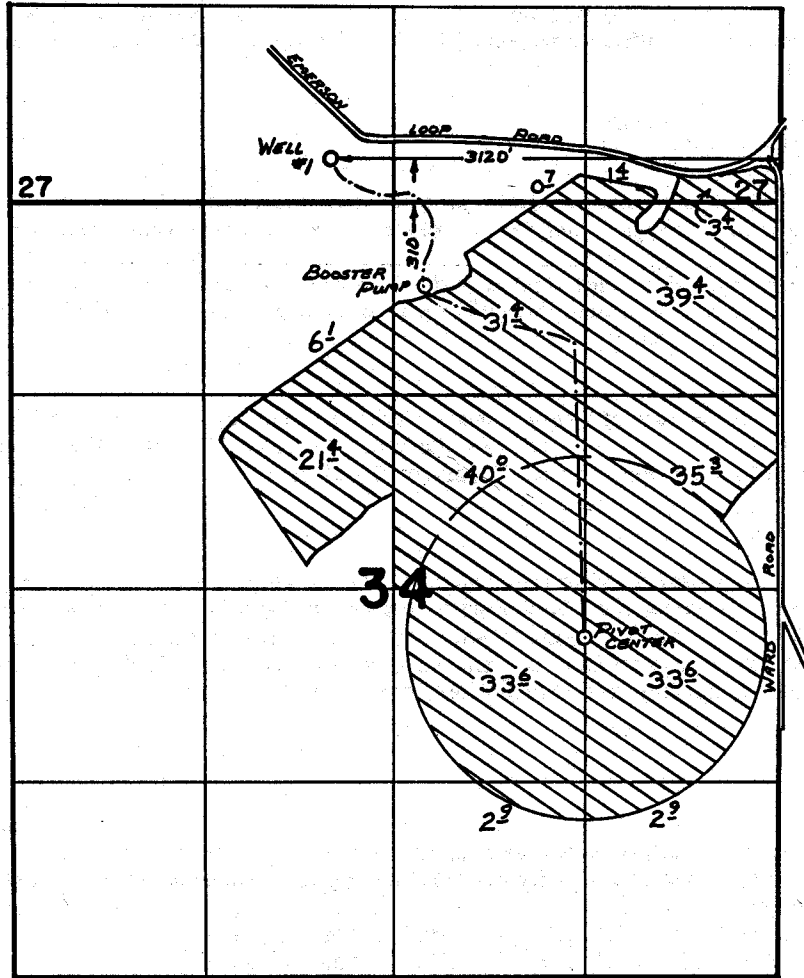

## FINAL PROOF SURVEY UNDER

Application No. G-7437... Permit No. G-6934....

IN NAME OF

VAN HARTH

Surveyed Sept. 20. 1982., by J.J. Paul.....