


T.4S. R.12E. W.M.

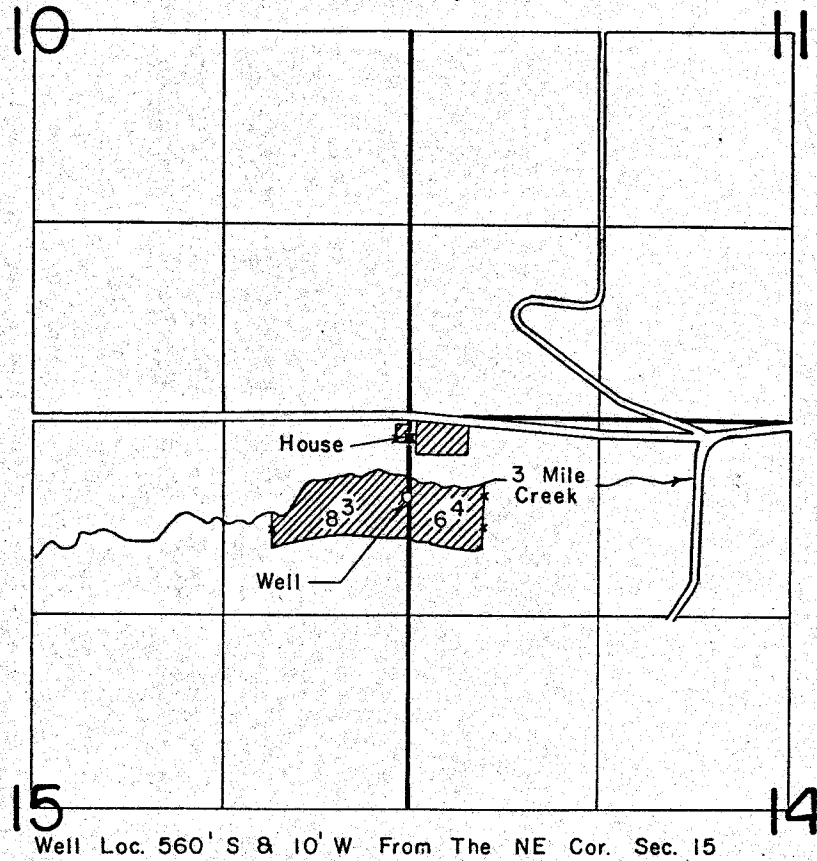

FINAL PROOF SURVEY
UNDER

Application No. G-8033 Permit No. G-7434
IN NAME OF

CARL DARREL ASHLEY

Surveyed June 30 1982, by T. Paul