T. 4 S. R. 12 E. W.M.

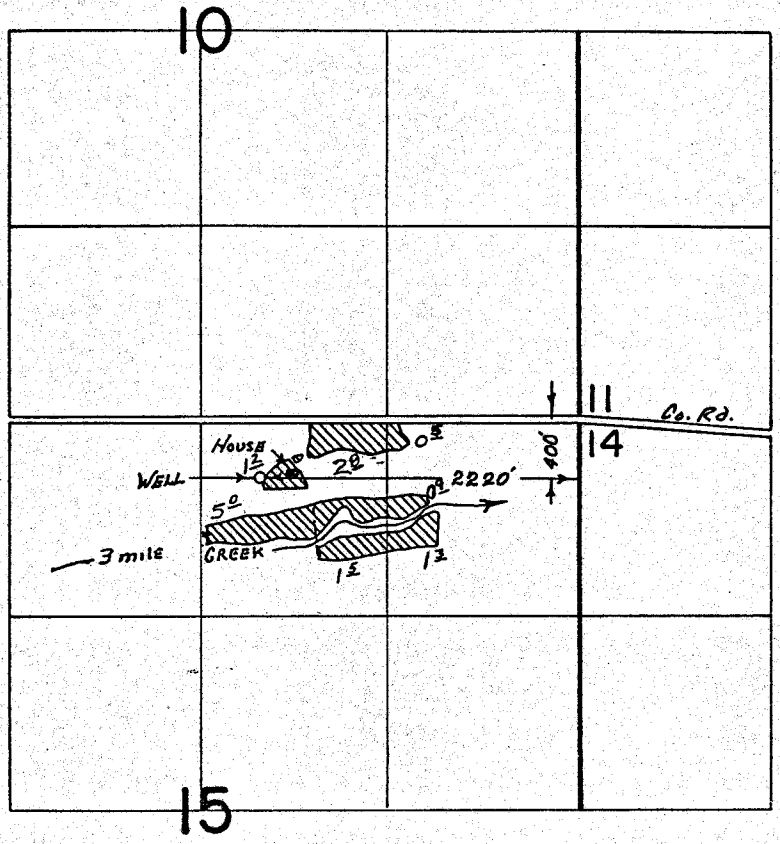

FINAL PROOF SURVEY
UNDER

Application No. G-8397 Permit No. G-7735
IN NAME OF

M. EUGENE ASHLEY

Surveyed Nov. 2 1983, by T. J. Paul

PNOTA 41065-179-2204