


T.2N. R.11 & 12E. W.M.

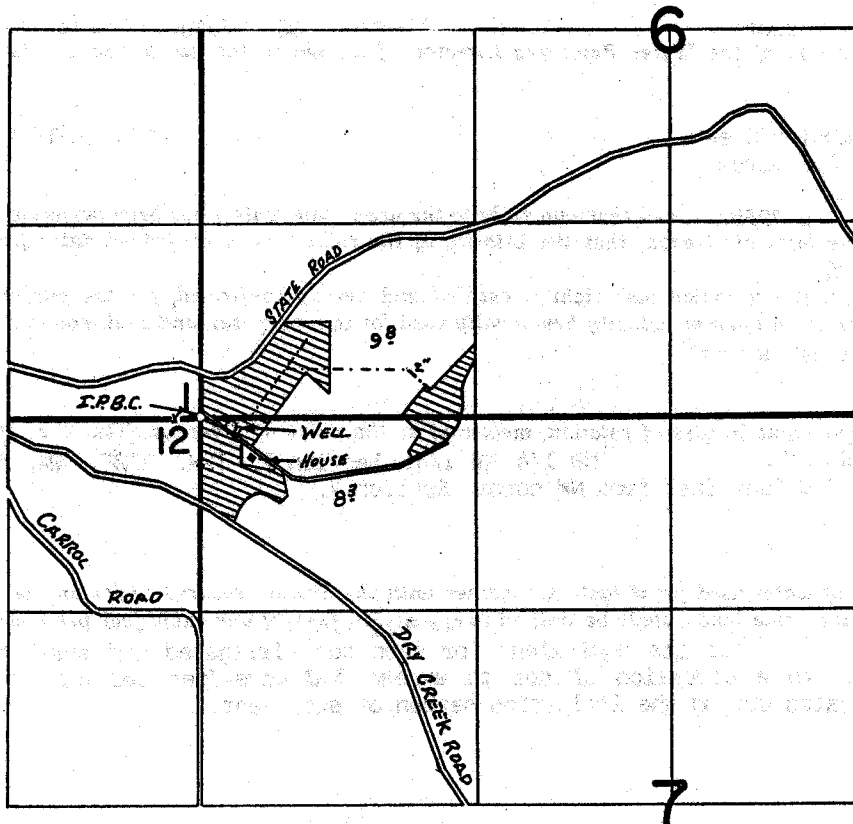

WELL LOC. 50'S & 210'E FROM THE NW COR. OF SEC. 7

FINAL PROOF SURVEY UNDER

Application No. G-8620 Permit No. G-7955
IN NAME OF

ROBERT HARRISON

Surveyed Nov. 6, 1984, by T. Paul