


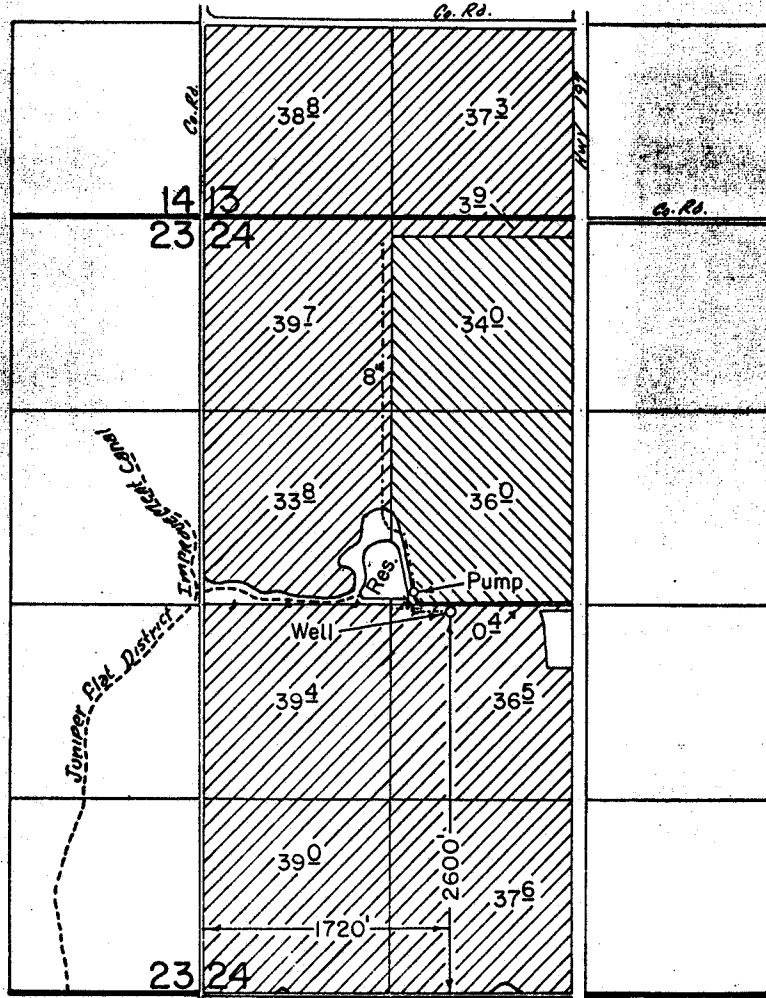

T.4S., R.13E., W.M.



 Primary
 Supplemental

FINAL PROOF SURVEY UNDER

Application No. G-8489. Permit No. G-8031.
IN NAME OF

.....ROBERT LARSELL.....

Surveyed Oct. 19, 1982, by T.J. Paul.....