


T.1N. R.13E. W.M.

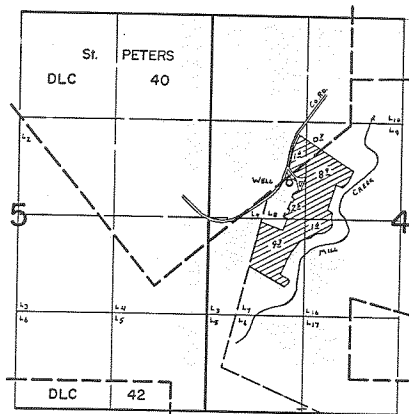

WELL Loc: 2260'S. (1090'E. of N.W. Cor. Sec. 9.

FINAL PROOF SURVEY

UNDER

Application No. G-7 Permit No. G-8498
IN NAME OF

INDEPENDENT ORDER OF ODDFELLOWS

Surveyed June 28, 1979, by C. J. HUGHES