


T. 1 N. R. 12 & 13 E. W. M.

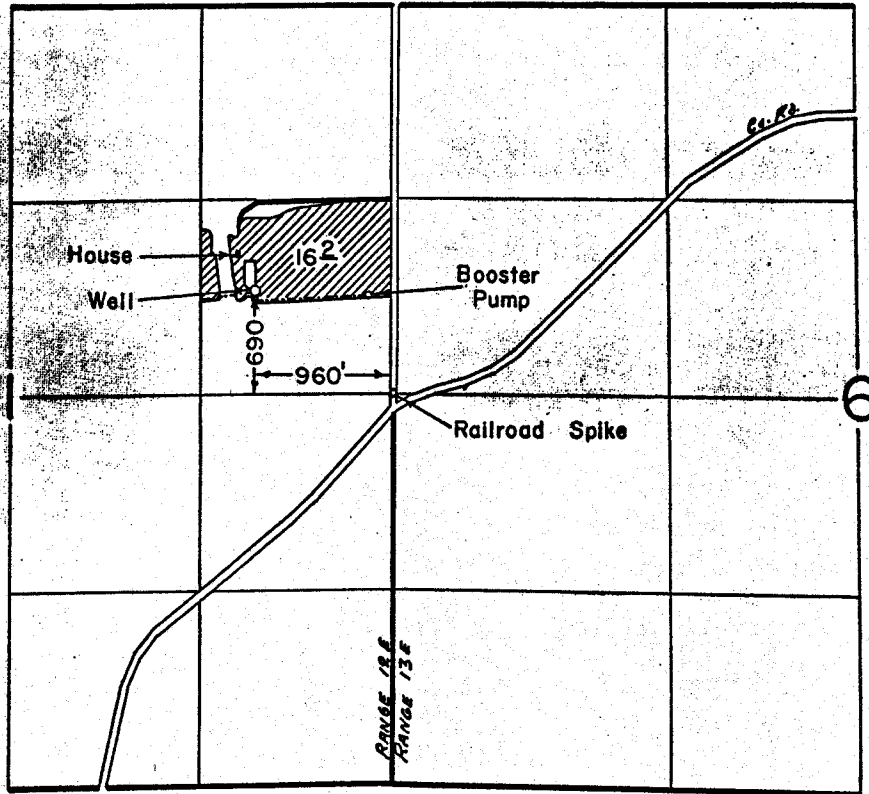

**FINAL PROOF SURVEY**  
UNDER

Application No. G-9790 Permit No. G-8960  
IN NAME OF

.....GEORGE A. MOORE.....

Surveyed March...11 1982, by T. Paul.....