


T. 3N., R. 2W., W.M.
SEC. 33

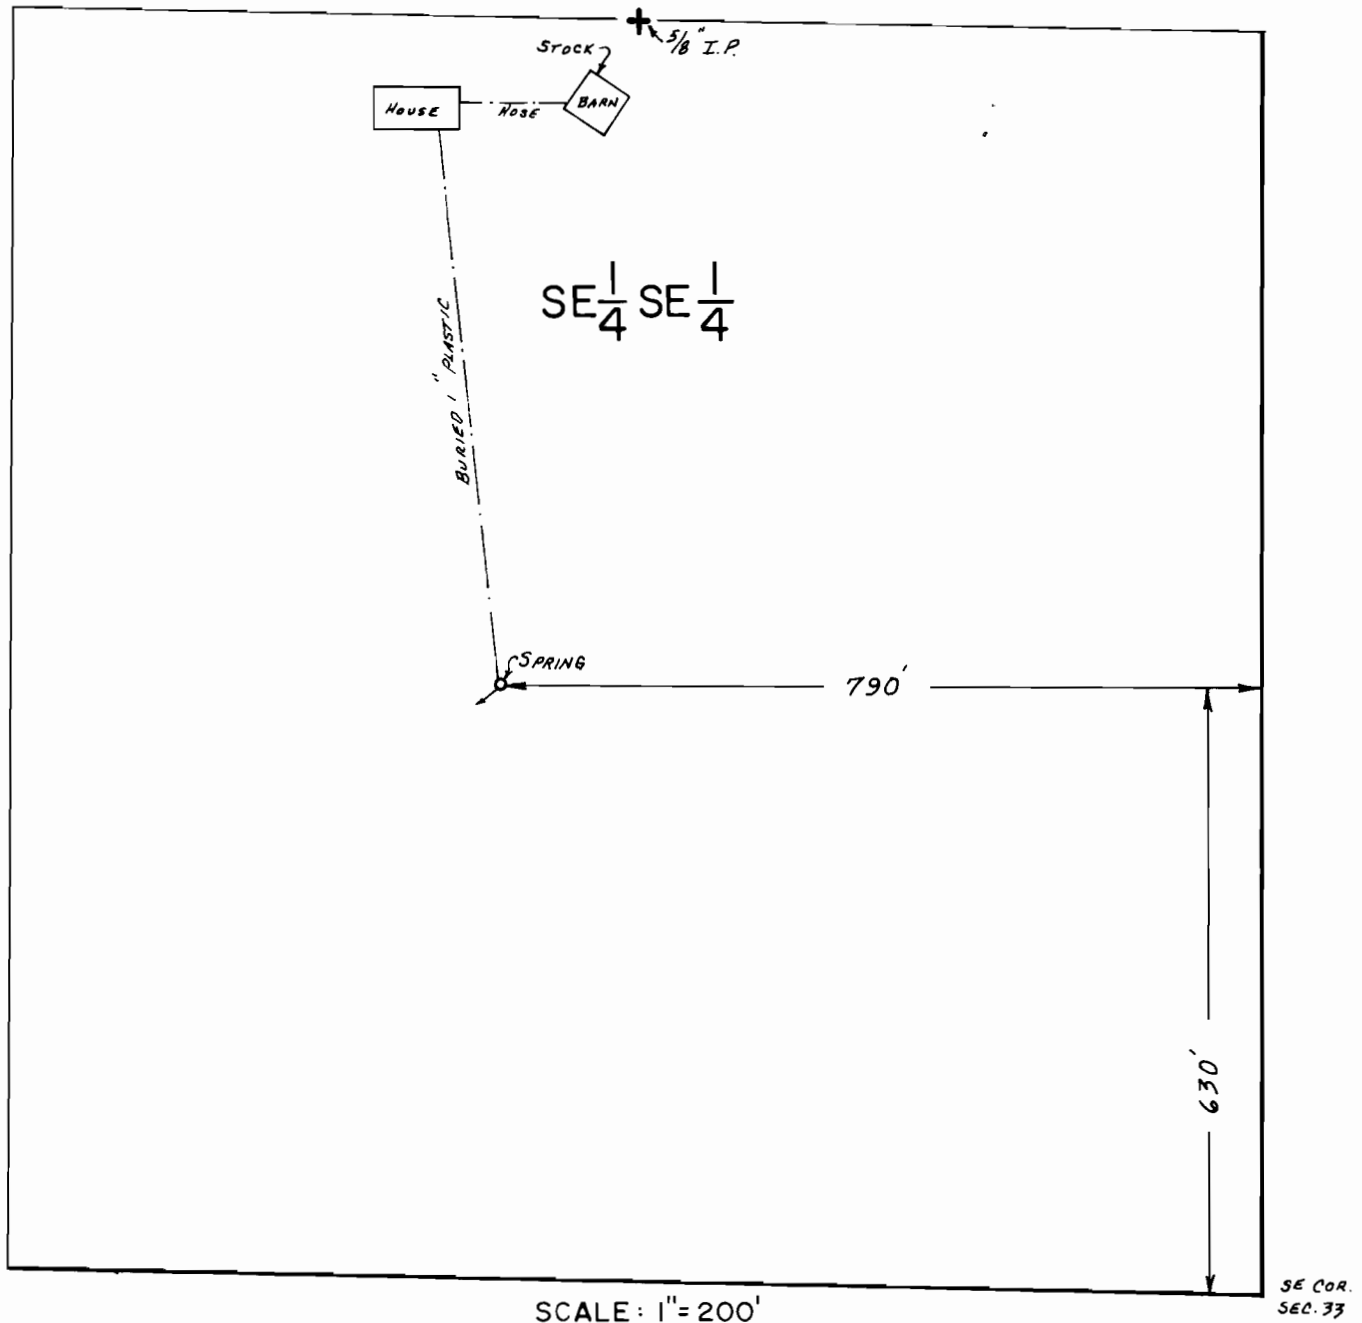

FINAL PROOF SURVEY
UNDER

Application No. 52047... Permit No. 39225.....
IN NAME OF

.....Richard Ferris.....

Surveyed JULY 24, 1980, by R.G. MUCKEN.....