


P-37751

55361

T. 8S., R. 19E., W.M.

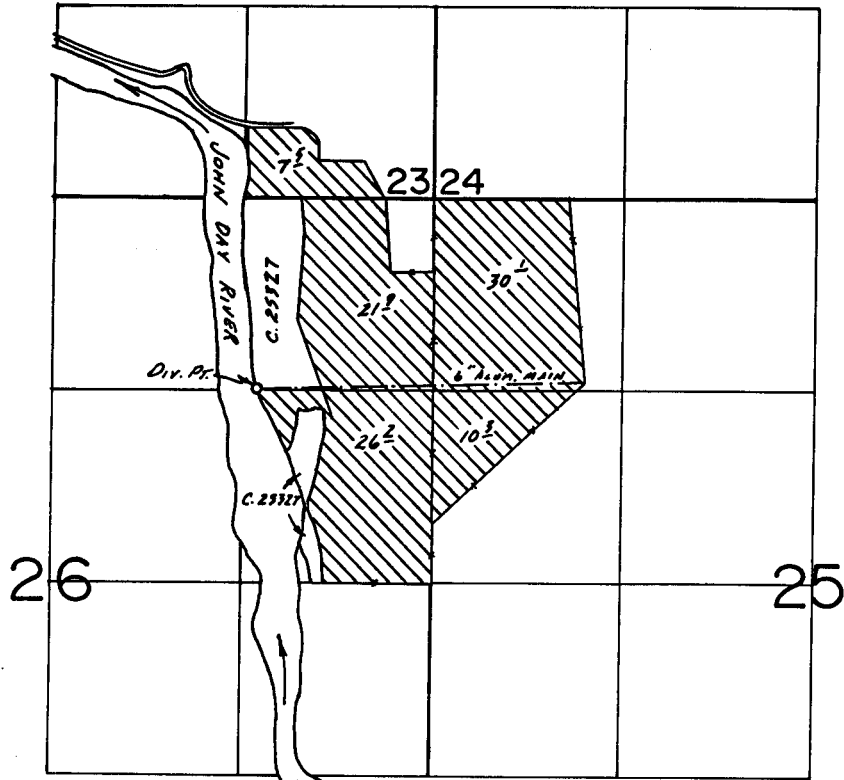

Div. Pt. Loc: 1590 N. of 1240 W. FROM E. 1/4 COR. SEC. 26.

**FINAL PROOF SURVEY**  
UNDER

Application No. 52636... Permit No. 37751.....

IN NAME OF

.....BILLY M. CROSS.....

Surveyed JUNE 26, 1980., by S.C. BROWN.....