


T.2S. R.2E. W.M.

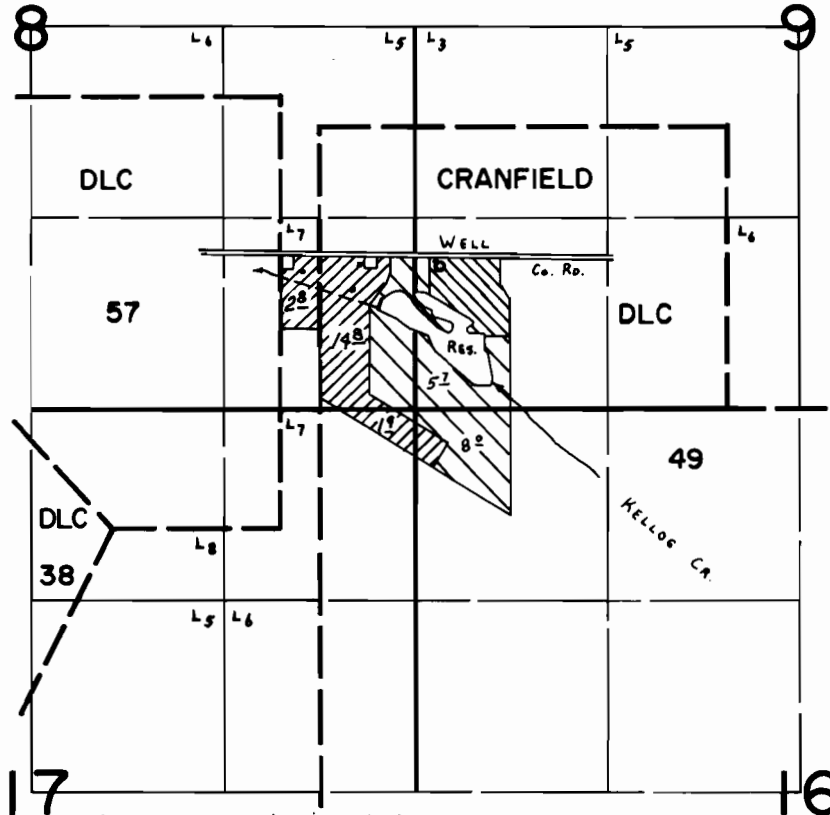

WELL LOC: 980' N. & 170' E. } BOTH FROM S.W. COR. SEC. 9.
 DAM LOC: 730' N. & 230' W. }

- DOMESTIC & COMMERCIAL USE (APP. G-4847); IRRIGATION (APP. 46050)
- IRRIGATION (APP. 46050)
- DOMESTIC & COMMERCIAL USE (APP. G-4847)
- - COMMERCIAL LOCATIONS

FINAL PROOF SURVEY
 UNDER

R-46049 R-5439
 46050 34205
 Application No. ~~G-4847~~ Permit No. ~~G-4564~~...
 IN NAME OF

DELBERT E. & LEONA E. JOHNSON

Surveyed April 24, 1979, by C. L. HUGHES.....