


T.2S. R.2E. W.M.

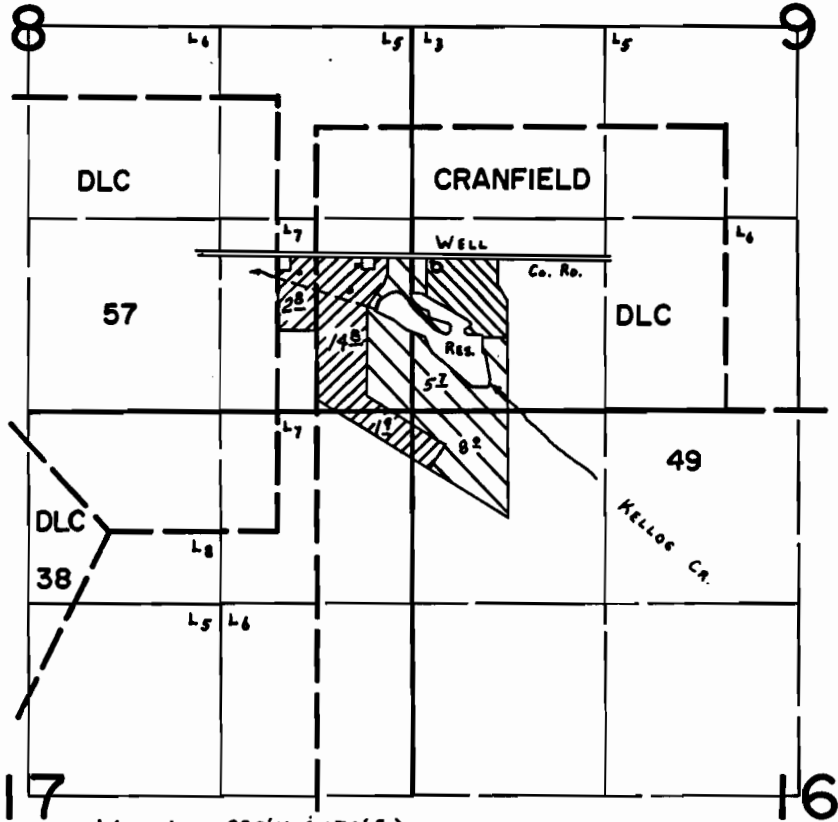

WELL LOC: 980' N. (170' E.)

DAM LOC: 730' N. (230' W.) } BOTH FROM S.W. COR. SEC. 9.

▨ - DOMESTIC & COMMERCIAL USE (APP. G-4847); IRRIGATION (APP. 46050)

▨ - IRRIGATION (APP. 46050)

▨ - DOMESTIC & COMMERCIAL USE (APP. G-4847)

• - COMMERCIAL LOCATIONS

FINAL PROOF SURVEY

UNDER

R-46049

R-5439

46050

34205

Application No. ~~G-4847~~ Permit No. ~~G-4564~~

IN NAME OF

DELBERT E. & LEONA E. JOHNSON

Surveyed April 24, 1979, by C. L. HUGHES.....