


T.3S. R.5E. W.M.

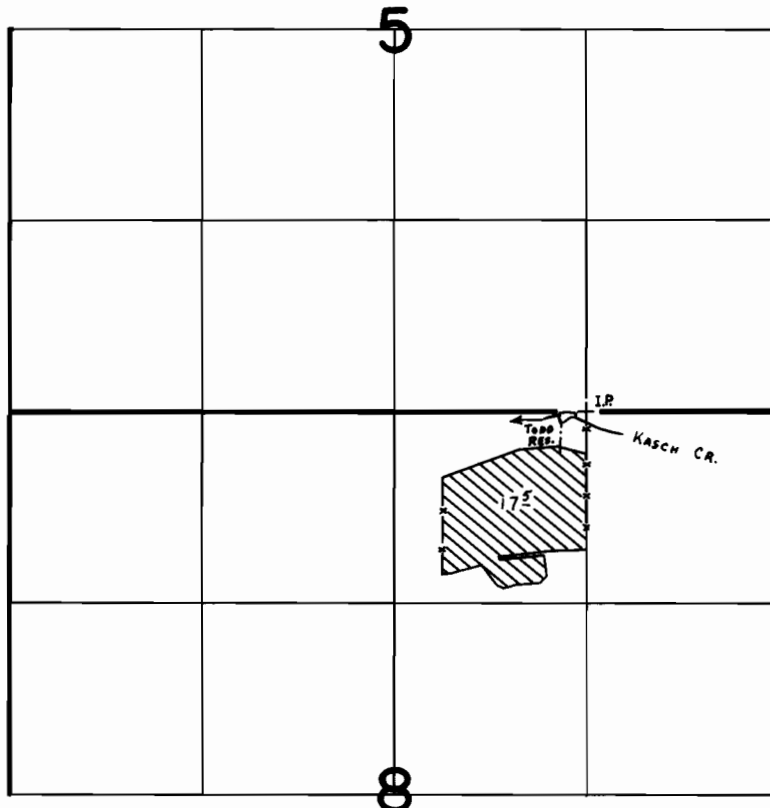

DAM Loc: 50'S. & 180' W. fr. N.E. Cor. of NW 1/4 NE 1/4 SEC 8.

FINAL PROOF SURVEY
UNDER

47884 35881
R-51326 R-6105
Application No. 51327... Permit No. 37714....
IN NAME OF

THOMAS N. & MARILYN H. KASCH

Surveyed April 26, 1979, by C. L. HUGHES....