


# T.4S. R.1E. W.M.

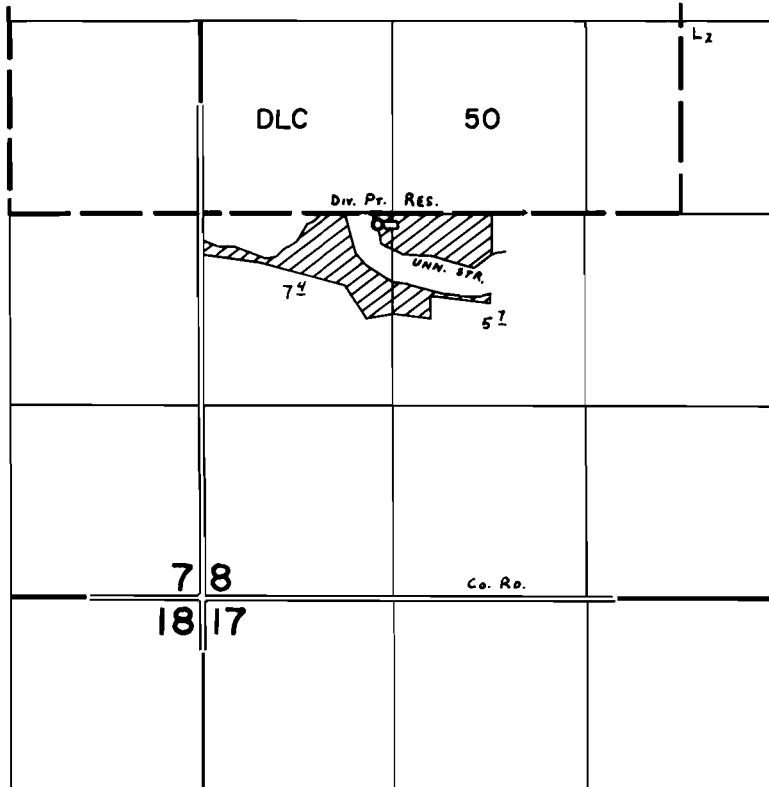

Div. Pr. Loc: 2570' N. & 1220' E. fr. S.W. CoR. Sec. 8.

## FINAL PROOF SURVEY UNDER

R-53881 R-6414  
Application No. ~~53882~~ Permit No. 40203.....  
IN NAME OF

**ZIEGLER FARM c/o VIOLA HURST**

Surveyed Oct. 17, 1979, by C. L. HUGHES.....