


T.4S. R.1E. W.M.

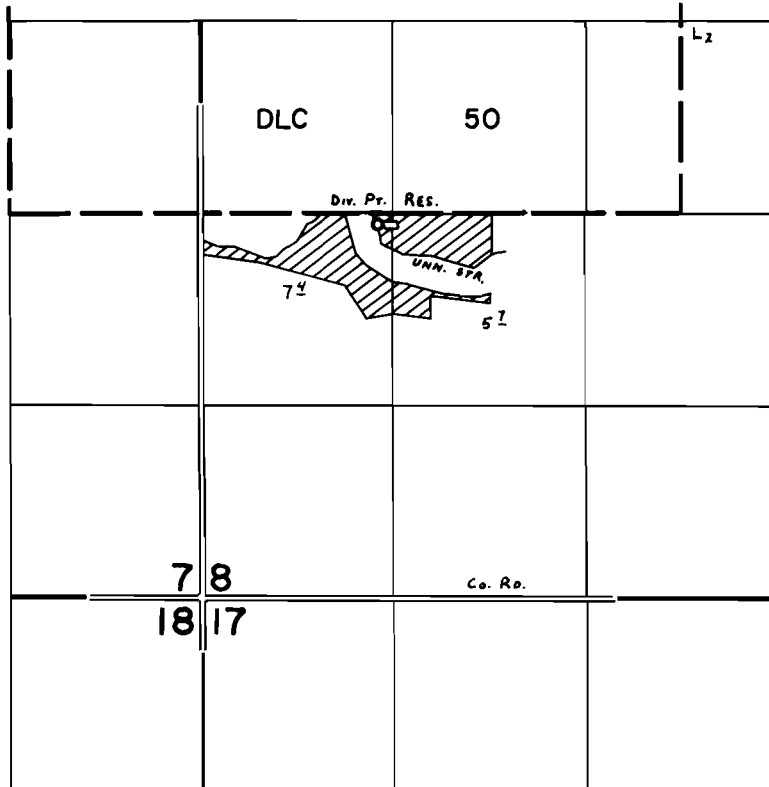

Div. Pr. Loc: 2570' N. & 1220' E. fr. S.W. Cor. Sec. 8.

FINAL PROOF SURVEY UNDER

R-53881 R-6414
Application No. ~~53882~~ Permit No. ~~40203~~.....
IN NAME OF

ZIEGLER FARM c/o VIOLA HURST

Surveyed Oct. 17, 1979, by C. L. HUGHES.....