


T.2S.R.3E.W.M.

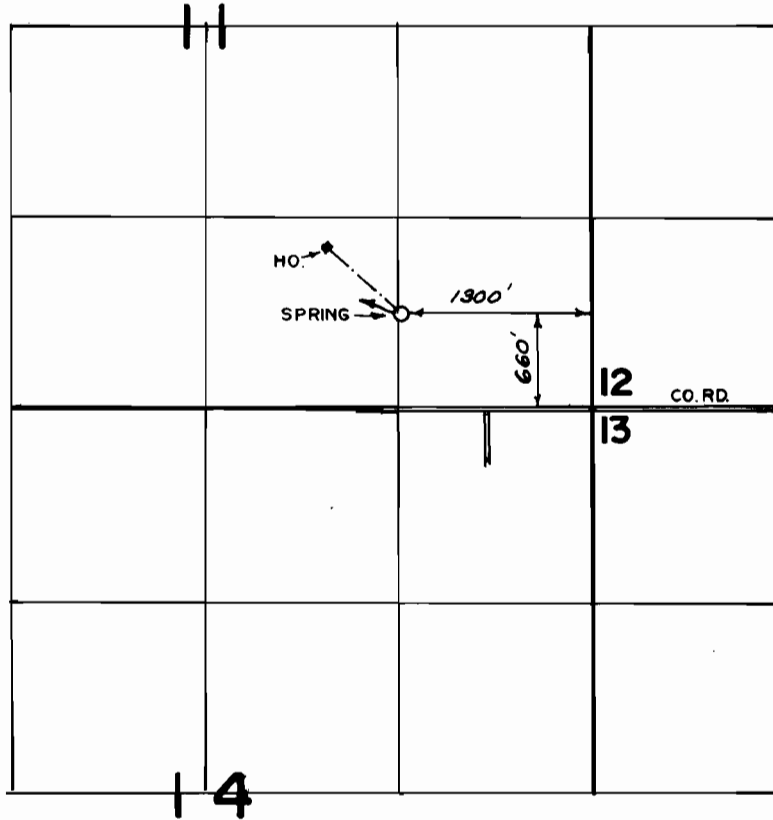

FINAL PROOF SURVEY UNDER

Application No. ~~54786~~ Permit No. 40905.....
IN NAME OF

..... HOWARD WESLEY PURVIS

Surveyed MAR. 20. 1980, by R.G. MUCKEN.....