


# T.38&4S.R.IE.W.M.

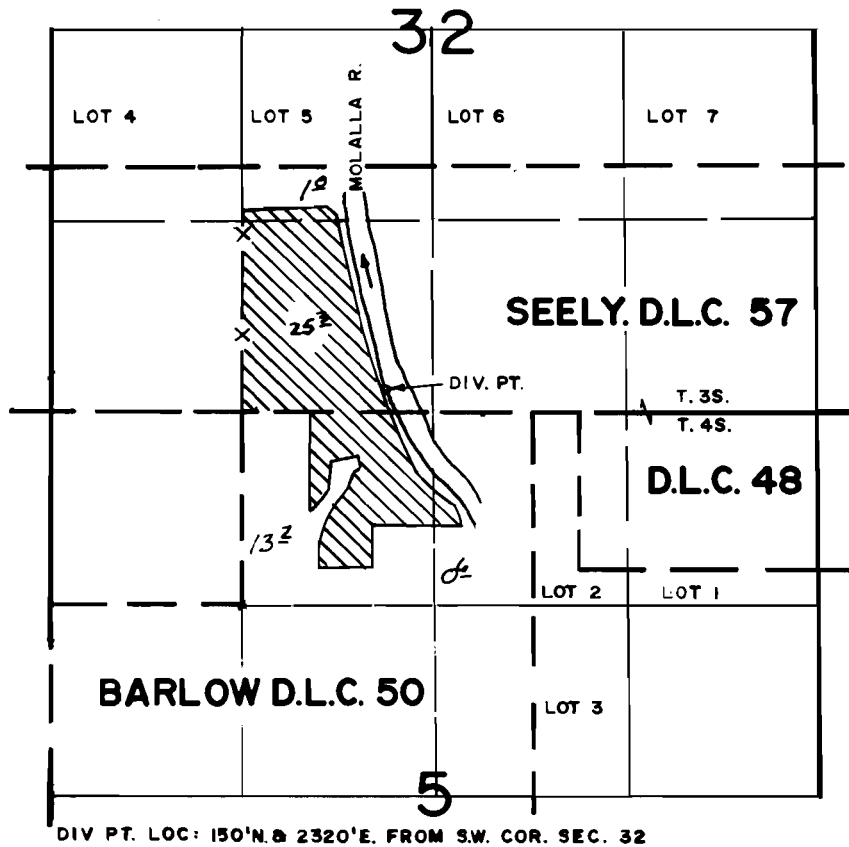

## FINAL PROOF SURVEY UNDER

Application No. 54922 Permit No. 41194.....  
IN NAME OF

ELMER W. GOODING

Surveyed JAN 17 1980, by R.G. MUCKEN.....