


55382

ALLIN T 2 N R 30 E W.M.

1" = 100'

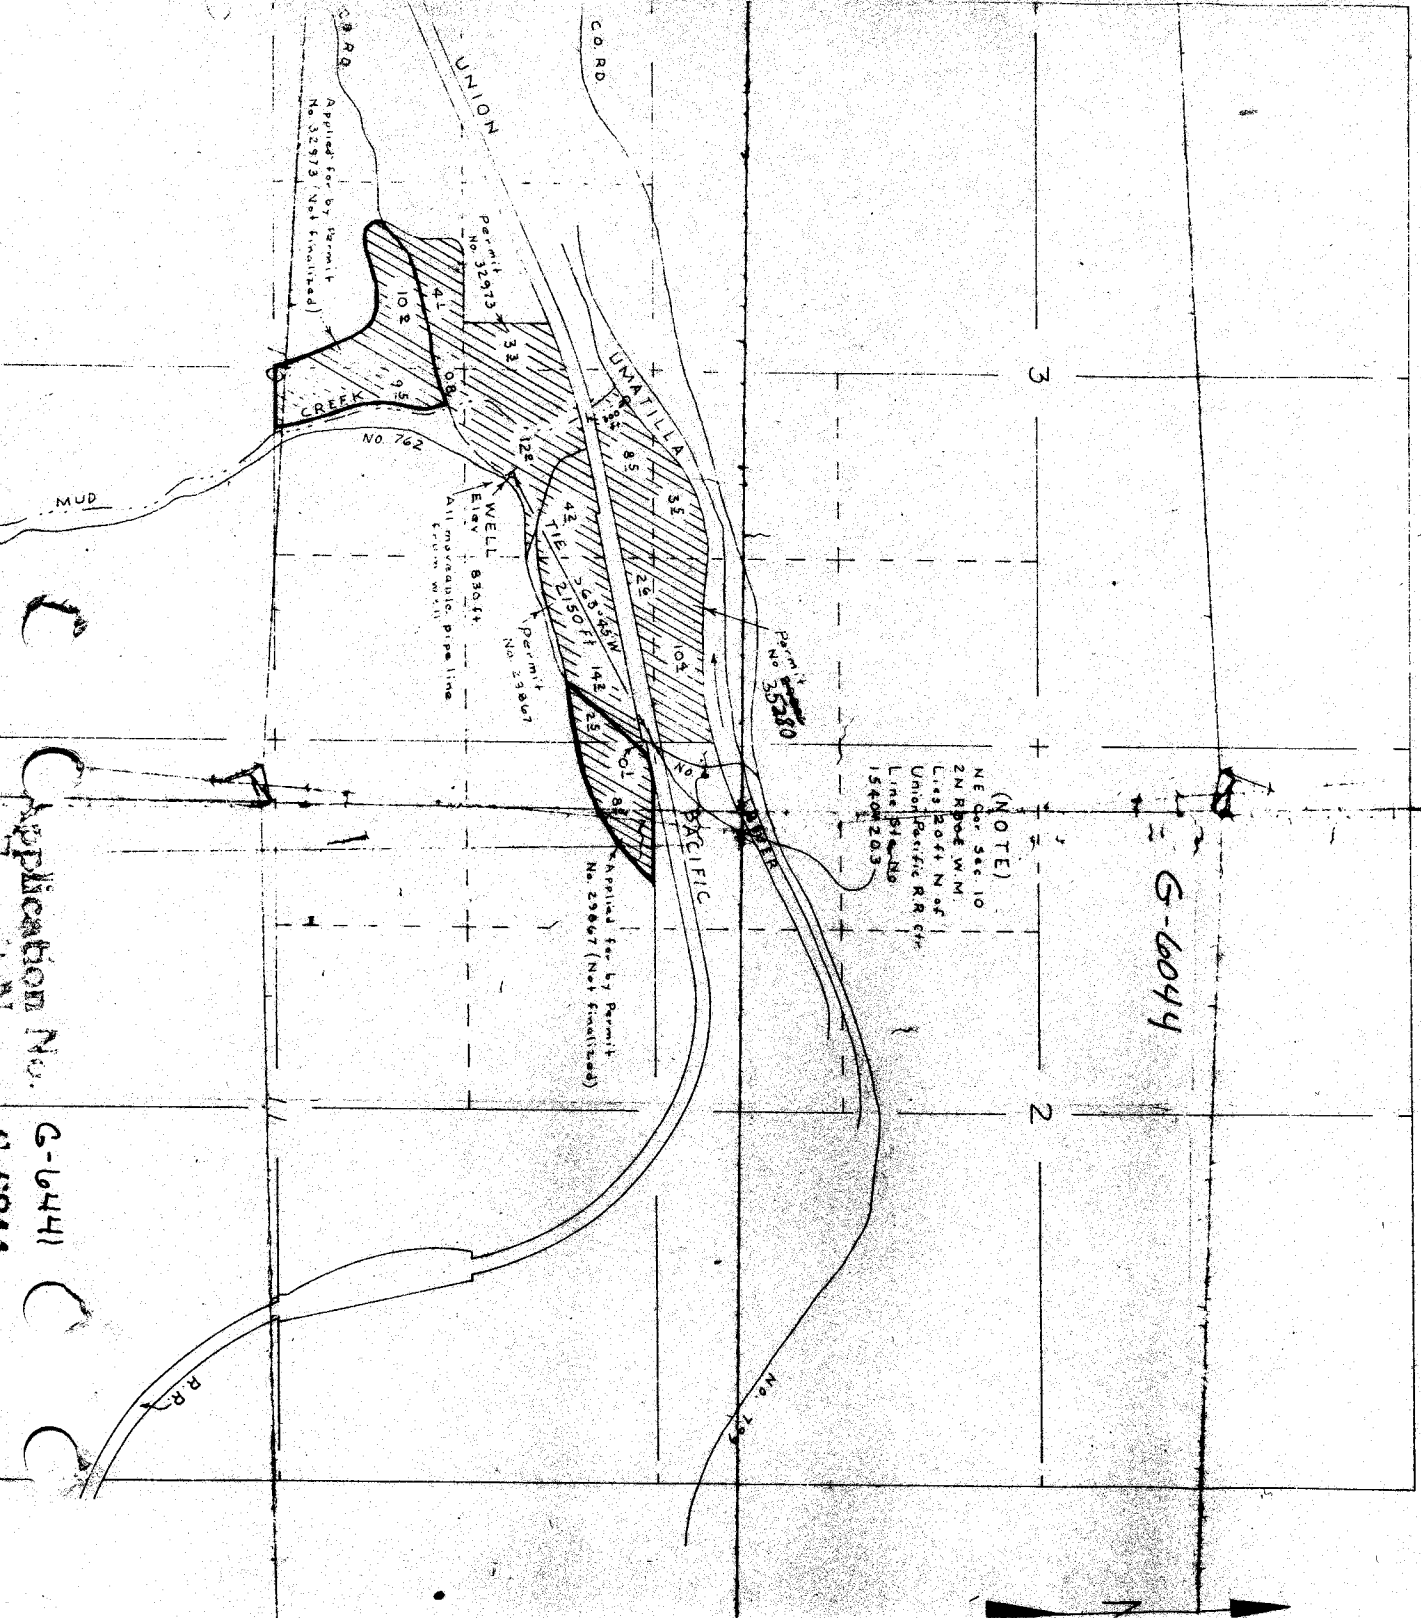

(NOTE)

NE Cor. Sec. 10
 2 N R 30 E W.M.
 Lies 20 ft N of
 Unio. Pacific R.R. 1540m 203'

G-6044

Application No.

G-6441

11 18884