


T. 4S., R. 1E., W. M.

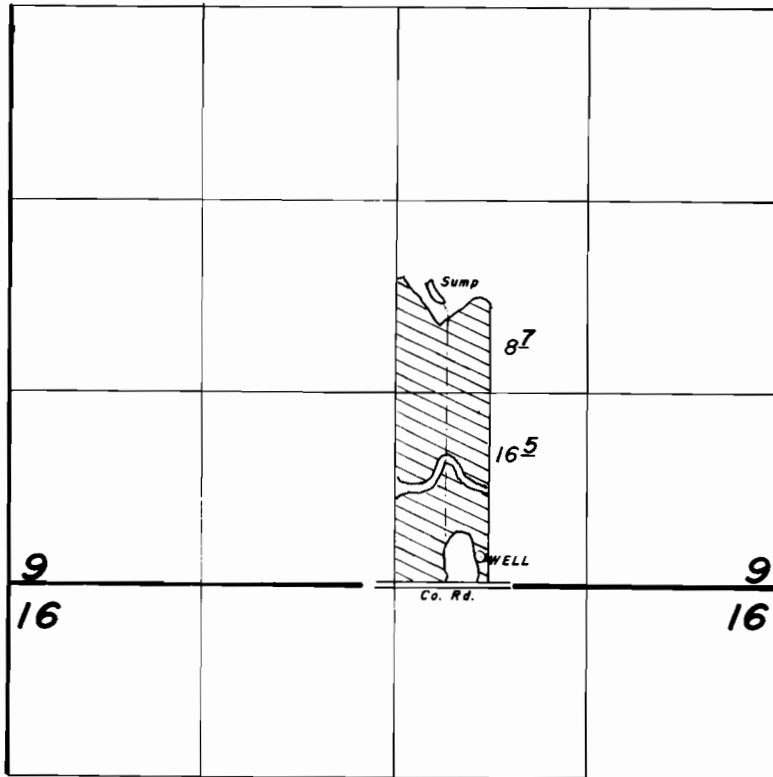

Well Loc.: 200' N. & 2050' W. from SE Cor. Sec. 9.
Sump Loc.: 1970' N. & 2350' W. from SE Cor. Sec. 9

1" = 1320'

FINAL PROOF SURVEY

UNDER

Application No. G-7731... Permit No. G-8532....
IN NAME OF

GARY LEE SAMBUCETO

Surveyed AUG. 28, 1984, by T. Warren.....