


# T. 5 S., R. 1 E., W.M.

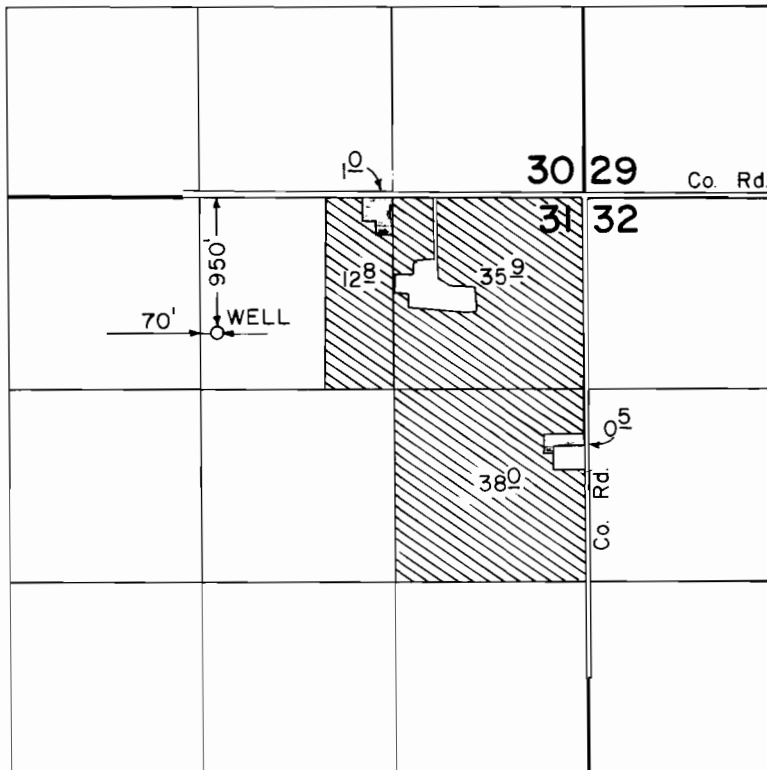

SCALE: 1" = 1320'

## FINAL PROOF SURVEY UNDER

Application No. G-9330 Permit No. G-8715.....  
IN NAME OF

JAMES W. MADSEN.....

Surveyed JUNE 17, 1985, by J.T. WARREN.....