




T. 4 S., R. 2 E., W.M.

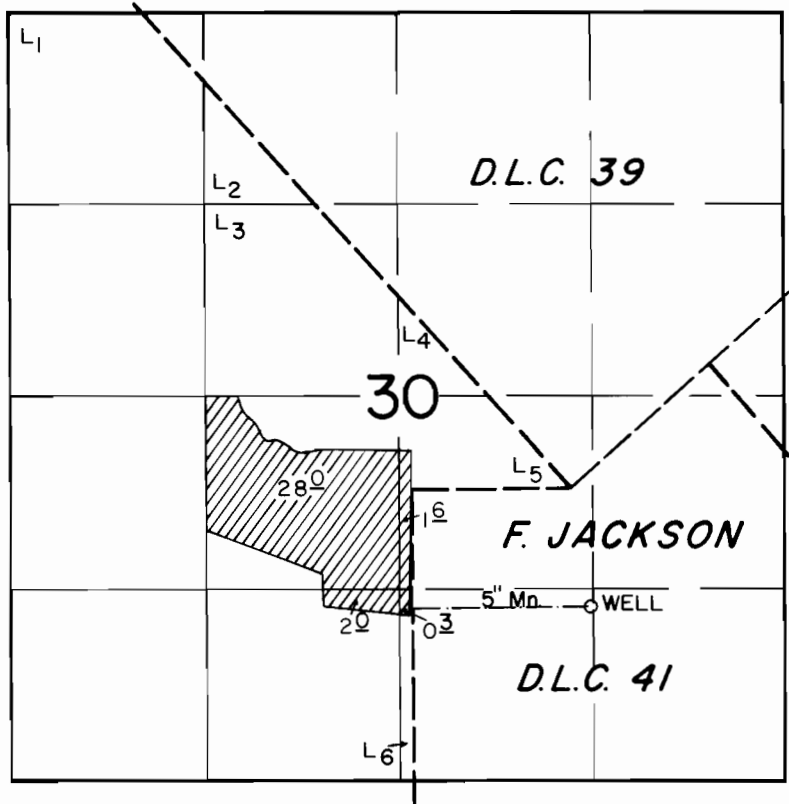

WELL LOC: 820' SOUTH & 1200' EAST FROM THE NW CORNER DLC 41

SCALE: 1" = 1320'

**FINAL PROOF SURVEY**  
UNDER

Application No. G-10283 Permit No. G-9632  
IN NAME OF

STEPHEN A. KOCH

Surveyed JULY 17, 1985, by T. WARREN