




T.14 S., R.17 E., W.M.

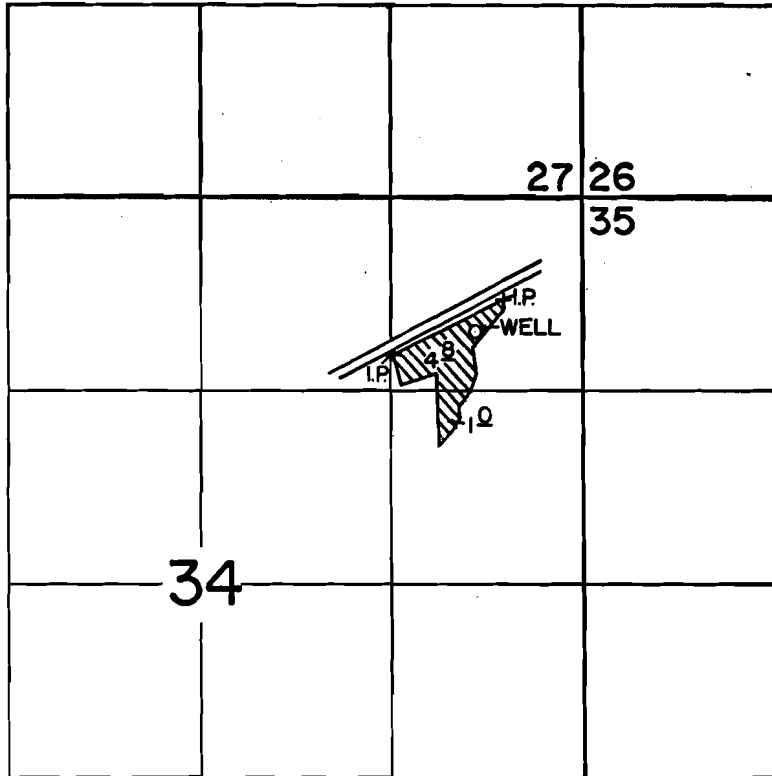

WELL LOC: 910' S. & 740' W. FROM THE N.E. CORNER SEC.34

SCALE: 1" = 1320'

**FINAL PROOF SURVEY**  
UNDER

Application No. G-9144 Permit No. G-8836  
IN NAME OF

..... TONY SOFICH .....

Surveyed AUG. 6, 1985, by T. WARREN

55389