


T.22S. R.6W. W.M.

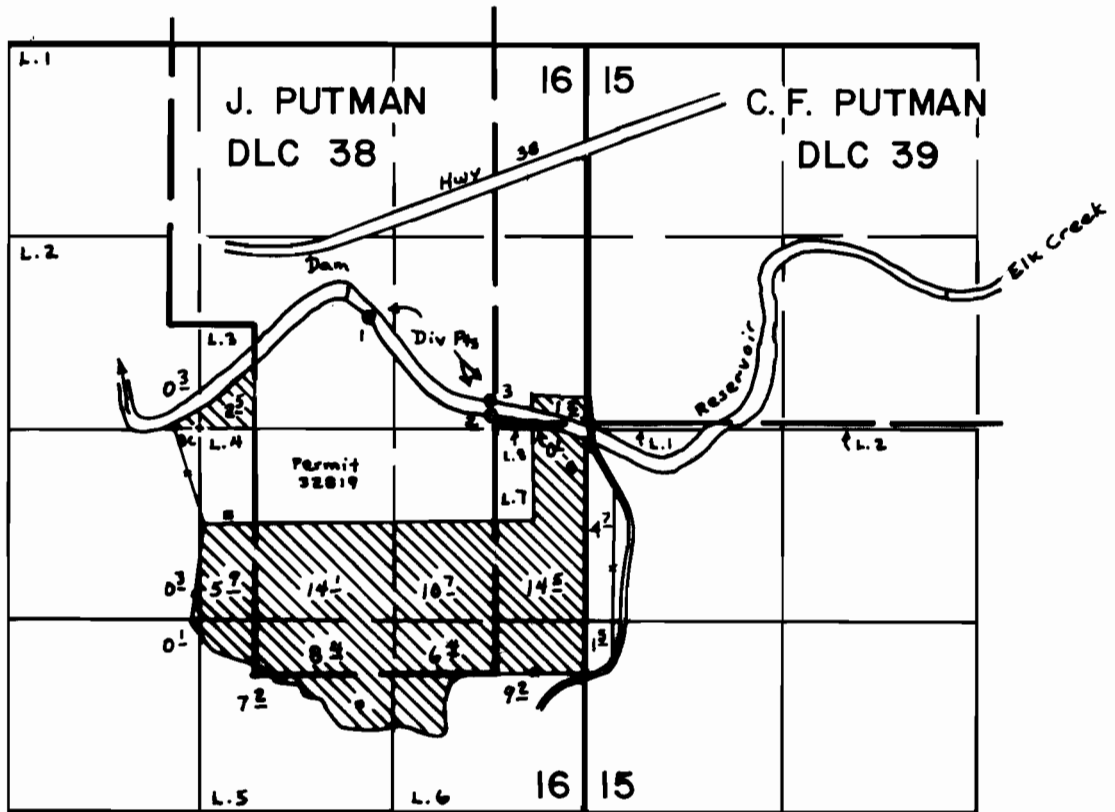

Div. Pts. Located: 1- 770' N & 1150' E; 2- 100' N & 1980' E; 3- 200' N & 1980' E;
 from the C. 1/4 Corner section 16; Dam- 940' N. & 1630' W. from the E. 1/4
 Corner Section 16. SCALE: 4" = 1 mile

FINAL PROOF SURVEY UNDER

Application No. 50547 Permit No. 38164
 IN NAME OF

BRUCE CUNNINGHAM

Surveyed Sept. 6, 1979, by S. Donaldson.