


T.29 S., R7W., W.M.
SEC. 4

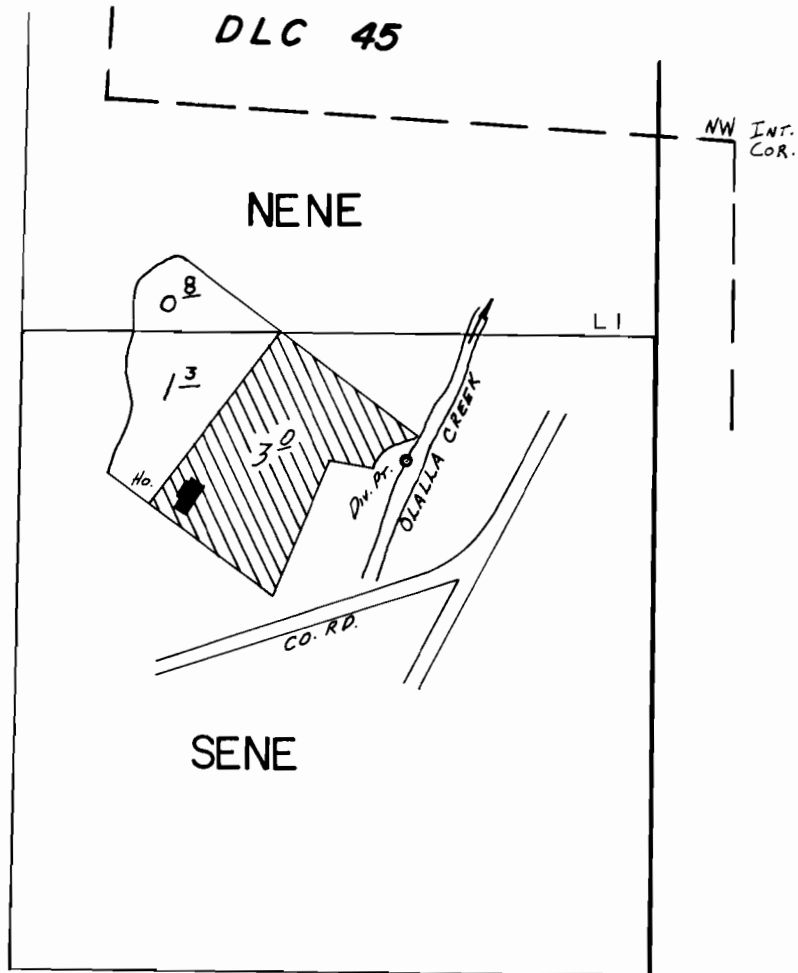

SCALE: 1" = 400'

POD Loc.: 680' S. & 670' W. from NW Interior Cor. CROXTON DLC 45.

FINAL PROOF SURVEY
UNDER

Application No. 52808 Permit No. 39857

IN NAME OF

CARL SMITH

Surveyed APR. 9 1980, by J.S. DONALDSON