


T. 30S., R. 5 W., W.M.

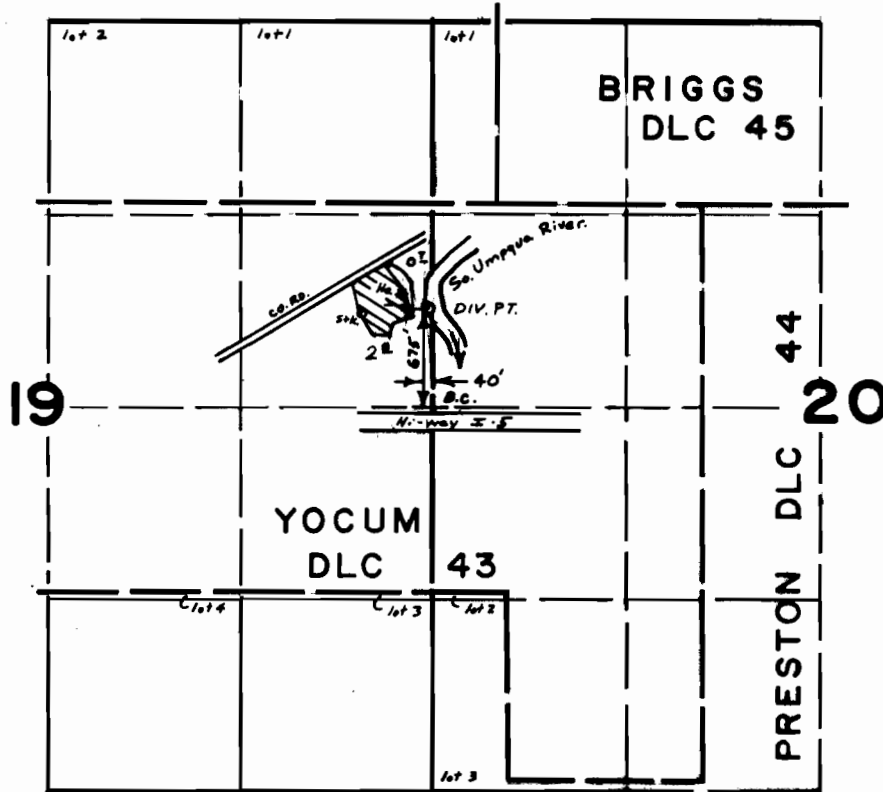

SCALE: 4" = 1 mile

FINAL PROOF SURVEY
UNDER

Application No. 56134. Permit No. 42288.
IN NAME OF

ARTHUR H. LEVASSEUR Jr.

Surveyed March 13, 1979, by S. Donaldson.