




T. 30 S., R. 6 W., W.M.

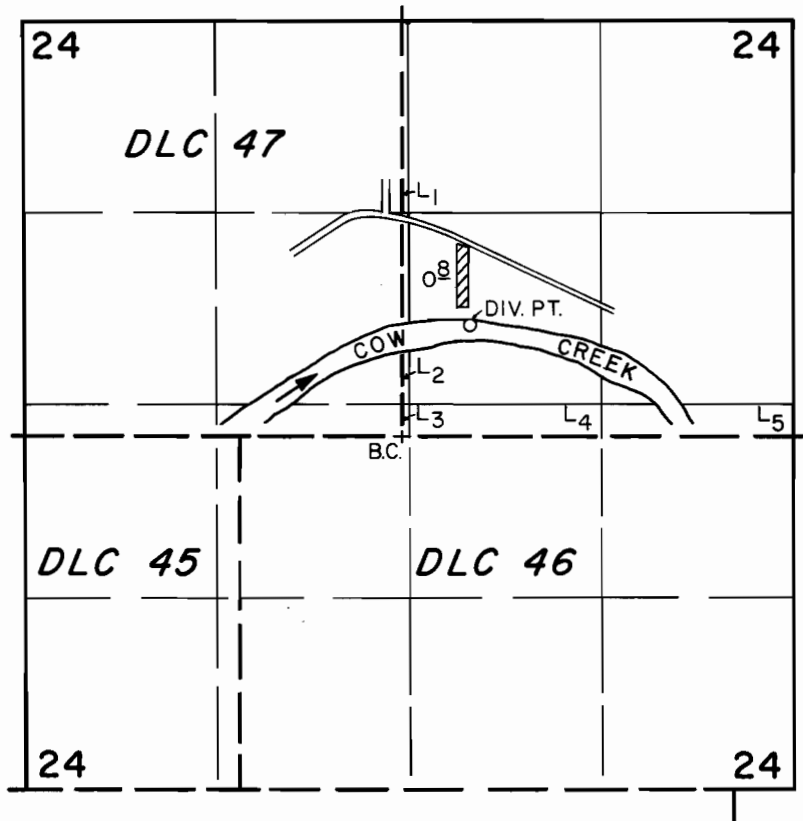

DIV. PT. LOC: 750' N. & 450' E. FROM THE SE. CORNER D.L.C. 47

SCALE: 1" = 1320'

FINAL PROOF SURVEY
UNDER

Application No. 58367.. Permit No. 43984.....
IN NAME OF

MICHAEL RAINWATER & DIANA RAINWATER

Surveyed JUNE 26, 1984, by L. CASHION.....