


T. 33 S., R. 5 W., W.M.

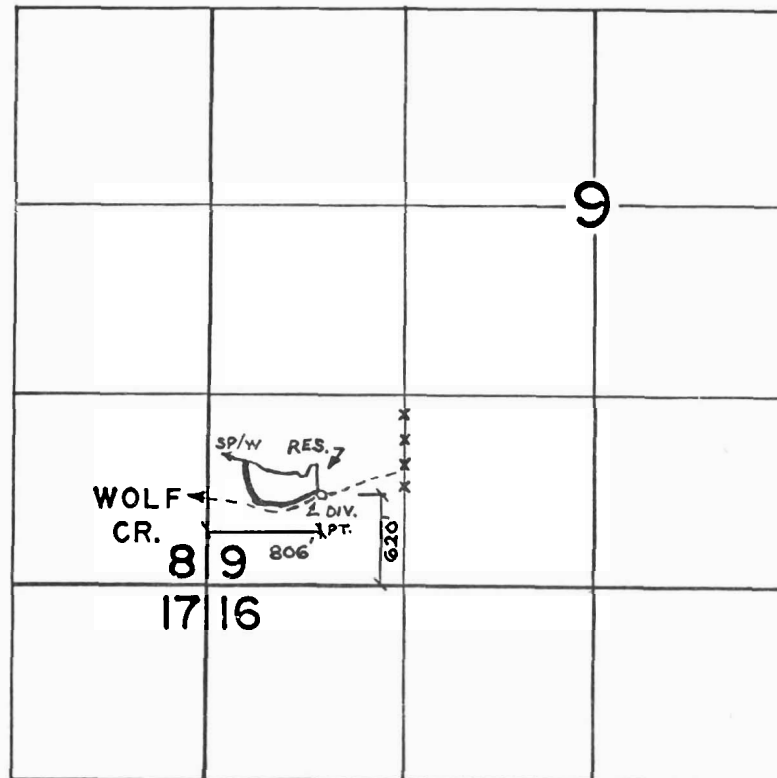

Section No.

R - 61078, 61079

R 8549

47244