


T. 33 S., R. 5 W., W.M.

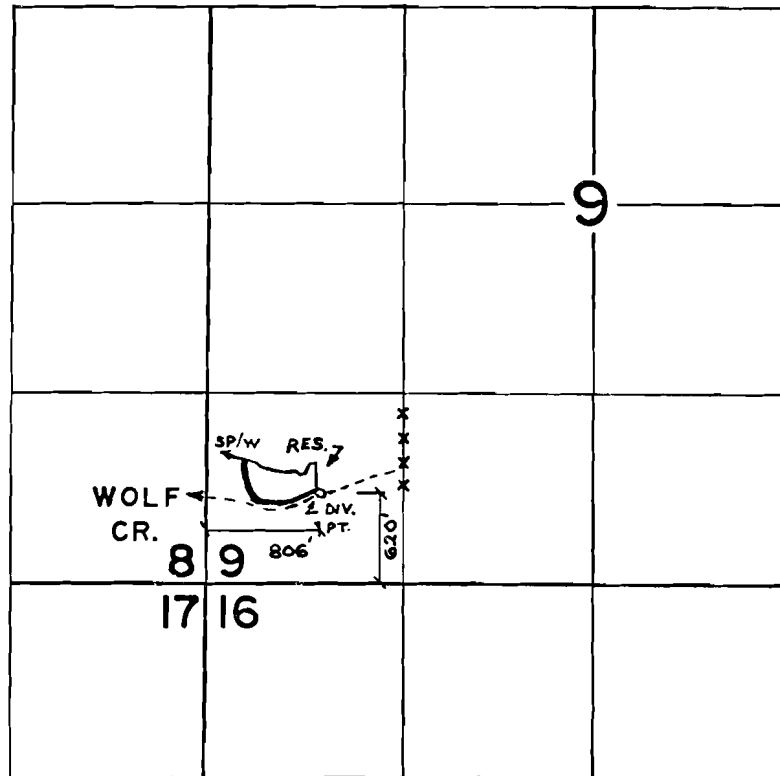

R - 61078, 61079
R 8519

47211