


T.34S., R.19E., W.M.

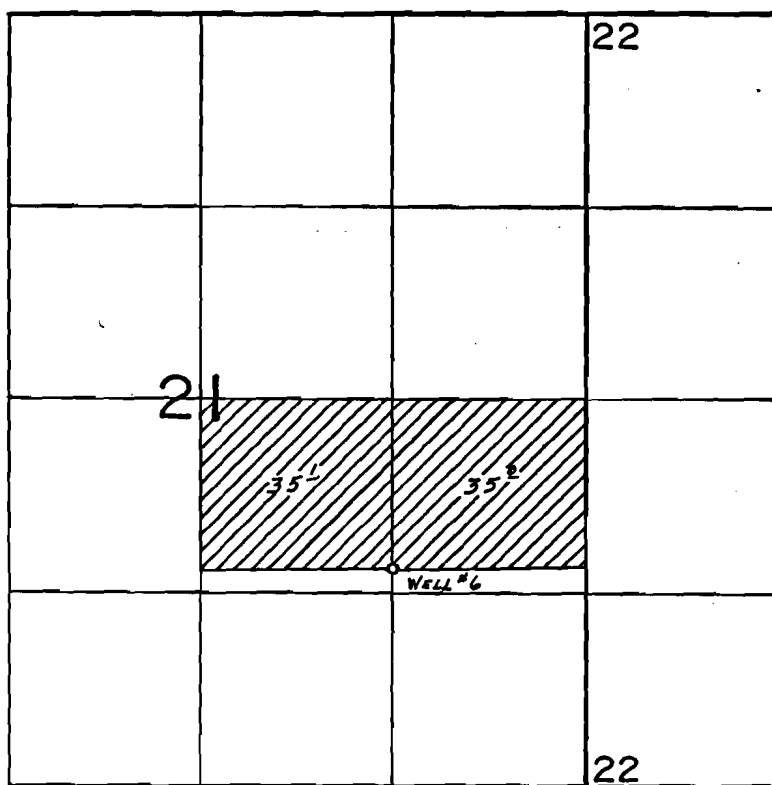

WELL LOC.: 1470' N. & 1320' W. FROM SE COR. SEC. 22

SCALE: 1"=1320'

FINAL PROOF SURVEY
UNDERApplication No. G-8017.. Permit No. G-7645....
IN NAME OF

.....SOLHEIM RANCH.....

Surveyed Oct. 16..... 1985, by B.W. BISHOP.....