FINAL PROOF SURVEY
FOR
RIVERVIEW DITCH ASSOCIATION
T.10S.R.2W.W.M.

Application 27207 Permit 21524

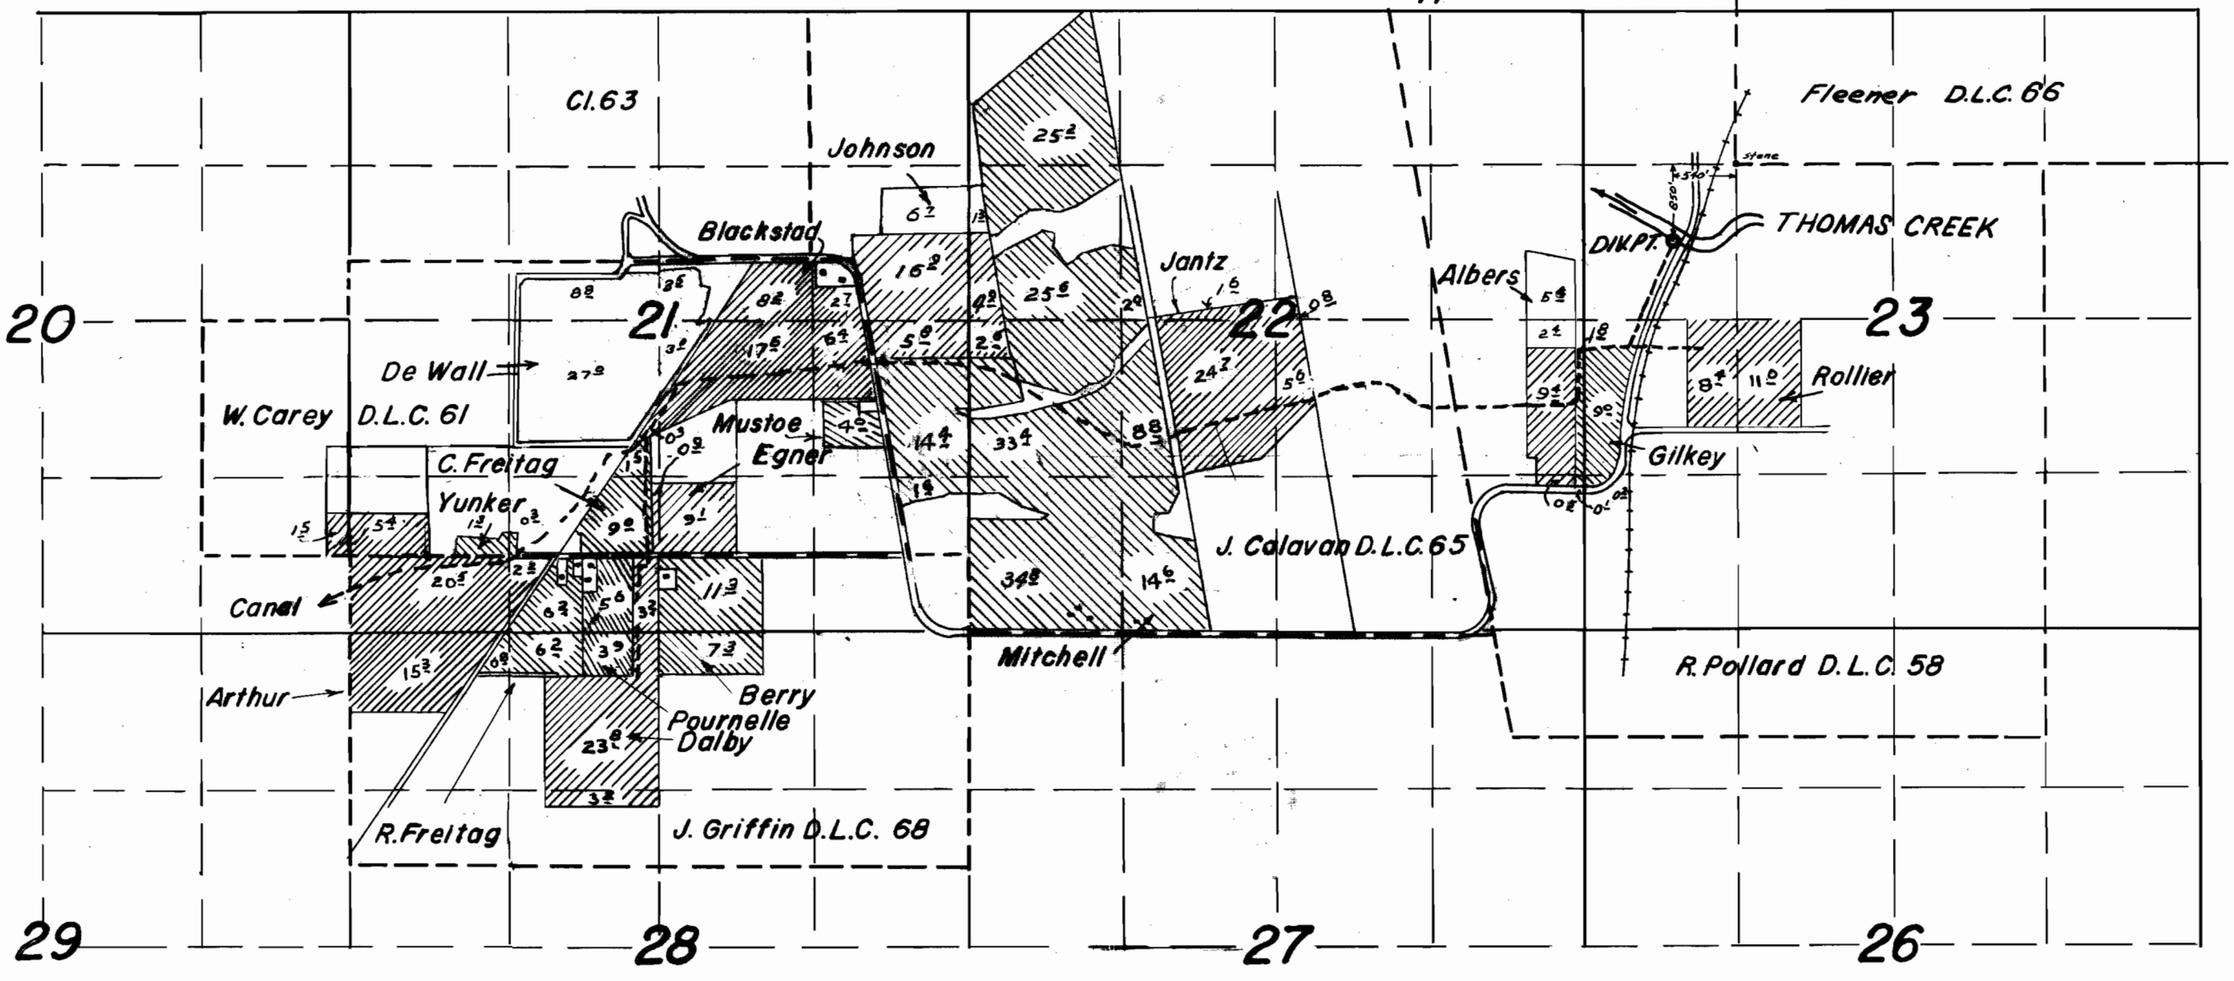

Surveyed May 10, 1965 by F. L. Siegmund

2-1964 A+B 2-1965 A DFM-2P-63