


T. 10S., R. 2W., W.M.

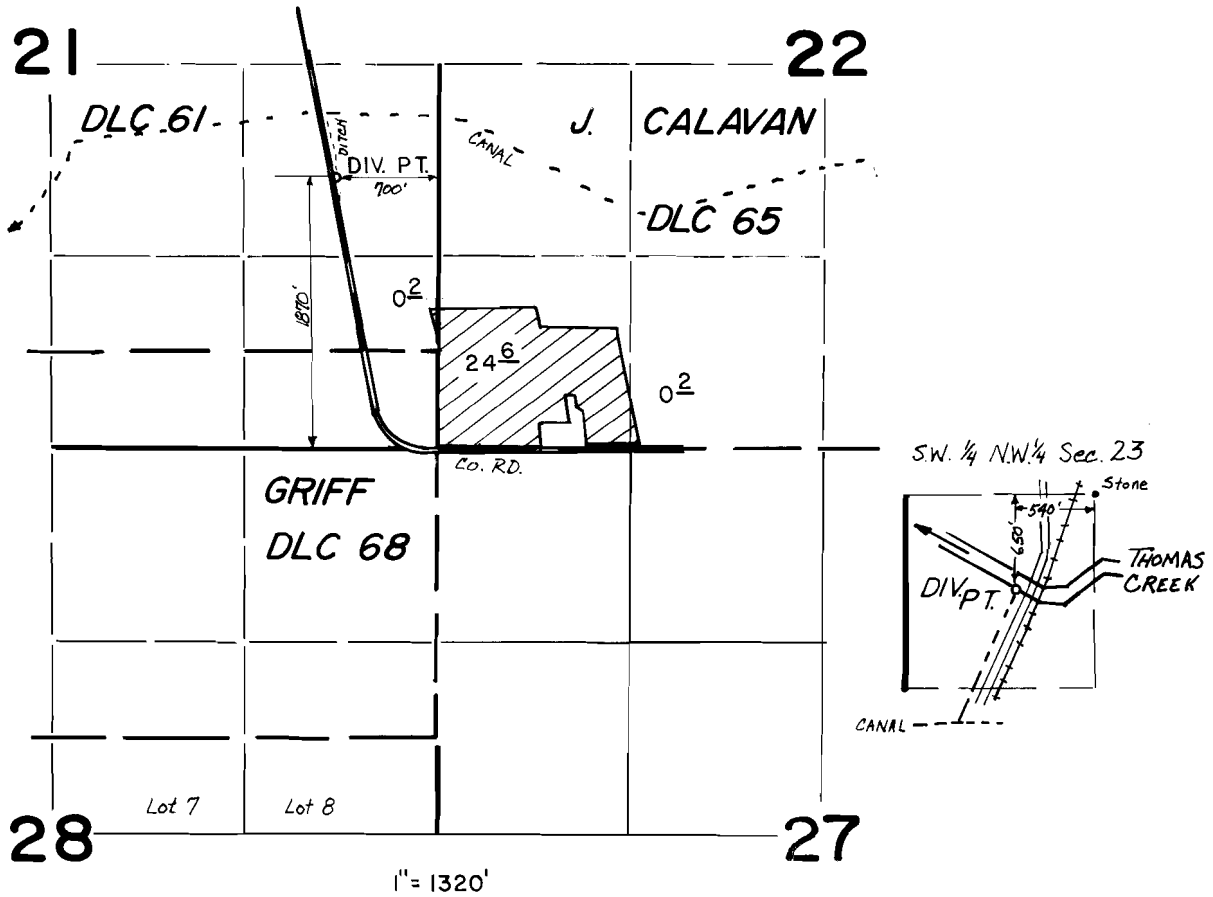

FINAL PROOF SURVEY UNDER

Application No. 55282.. Permit No. 42916.....
IN NAME OF

RIVERVIEW DITCH ASSOCIATION

Surveyed OCT. 18, 1983, by M. CAHILL.....