


T.13S., R.1W., W.M.

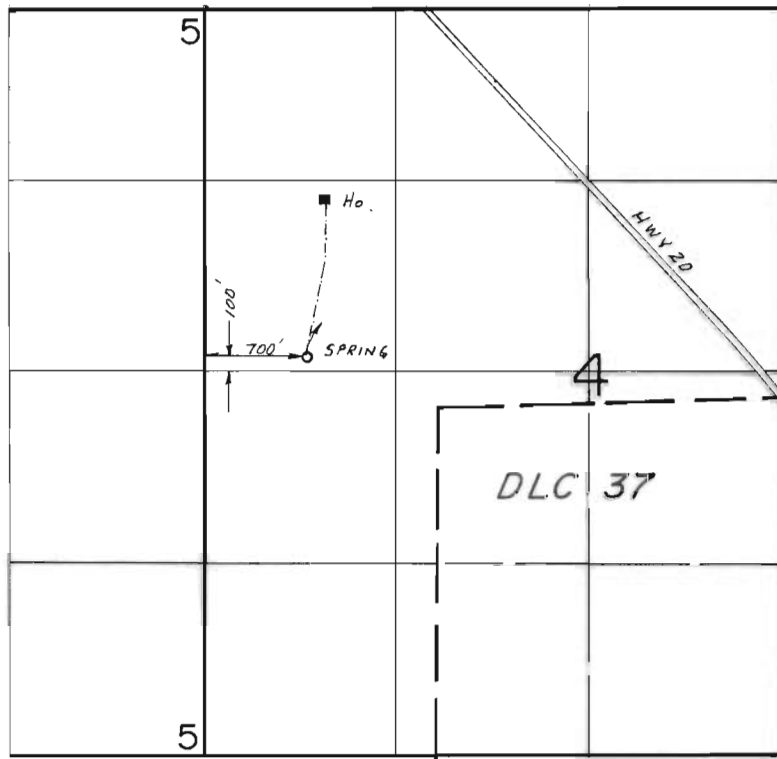

SCALE: 1"=1320'

# FINAL PROOF SURVEY

UNDER

Application No. 49518... Permit No. 37363.....  
IN NAME OF

WILLIAM E. EVANS.....

Surveyed Oct. 4..... 1985., by J.M. WARREN.....