


T.9S.,R.2W.,W.M.

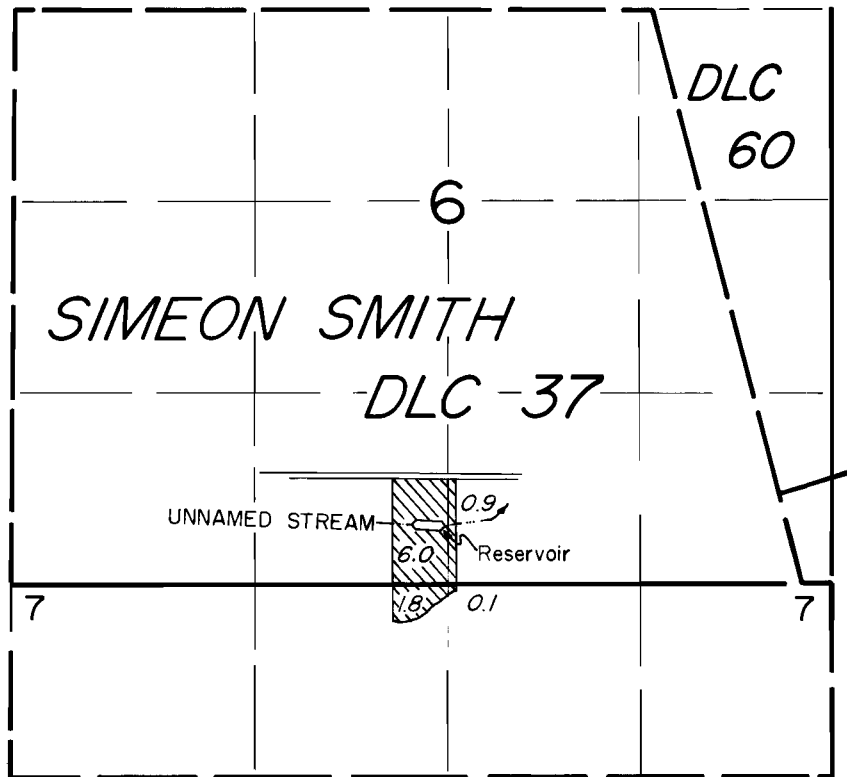

DIV. PT. LOC.: 400' N. & 2980' E. FROM SW COR. SEC. 6.

FINAL PROOF SURVEY
UNDER

R-52306 R-6299
Application No. 52338 Permit No. 39362....
IN NAME OF

Harold O. & Rosemary M. Miller

Surveyed OCT. 2, 1979, by *MB*