


Field Form For App. R-45152

T.4S. R.2W. W.M.

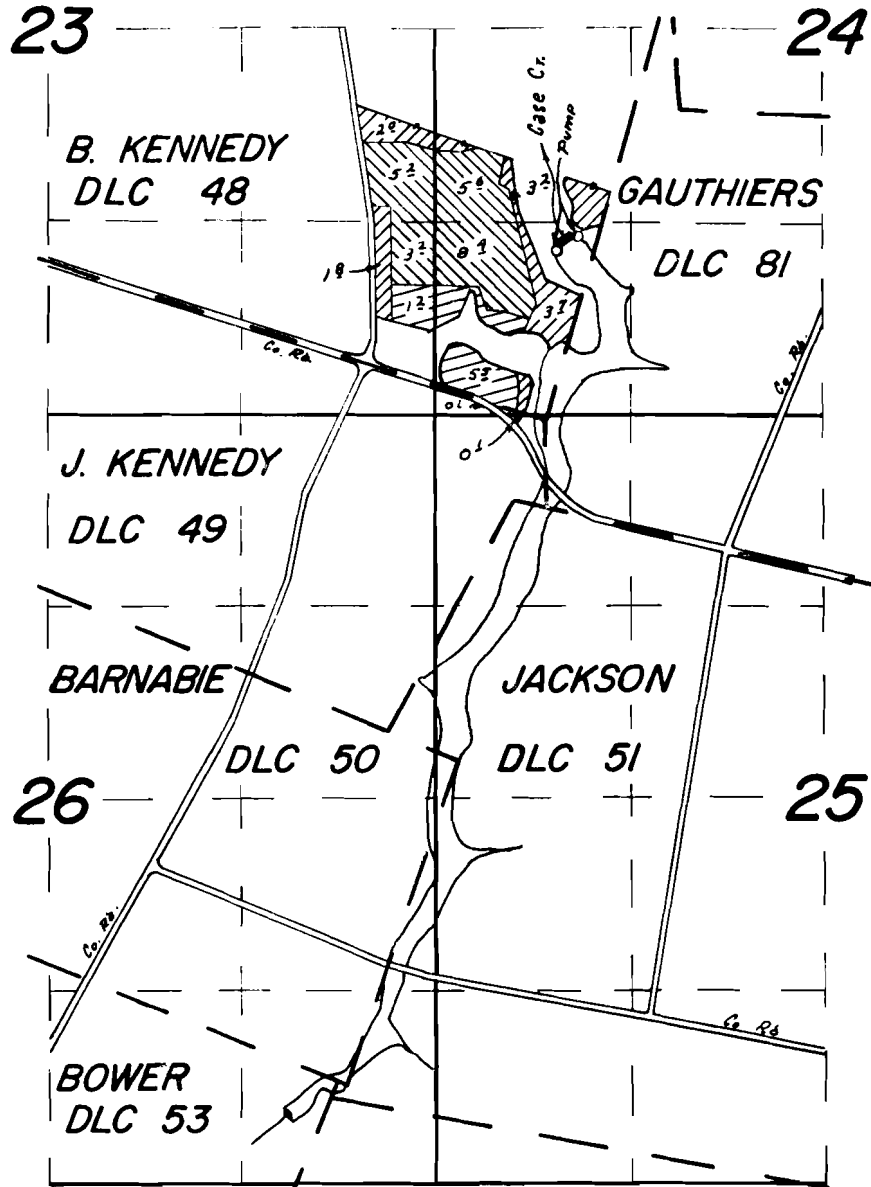

FINAL PROOF SURVEY
UNDER



Primary
 Supplemental
 Reservoir Only
 Supplemental
 Case Cr. Reservoir
 Dam Loc.: 1790' N & 370' E From
 NW Cor. Jackson DLC 51

R-44864
 Application No. 44865 Permit No. 34414
 IN NAME OF

HENRY WILMES

Surveyed May 25 1979, by T. J. Paul

This is an enlargement of the reservoir.